


T. 30S. R. 3&4W. W.M.

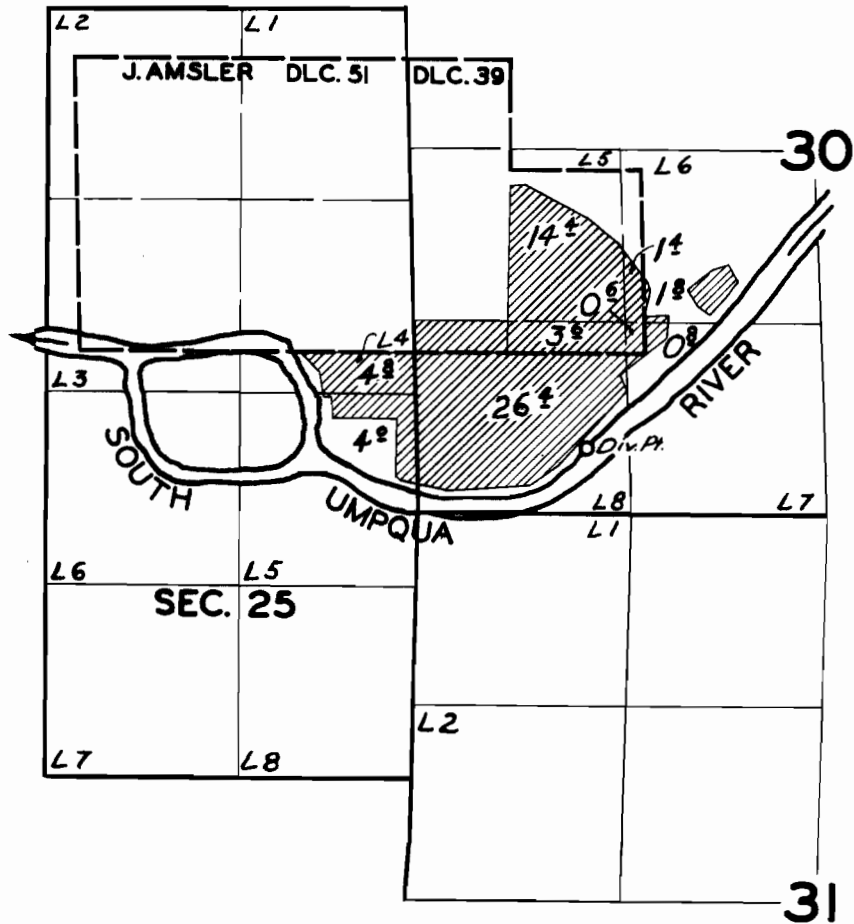

FINAL PROOF SURVEY  
UNDER

Application No. 22235 Permit No. 17542  
IN NAME OF

J. R. RITTER

Surveyed JUNE 24 1957, by *C. O. Burtch*