


# T.14S.R.15E.W.M.

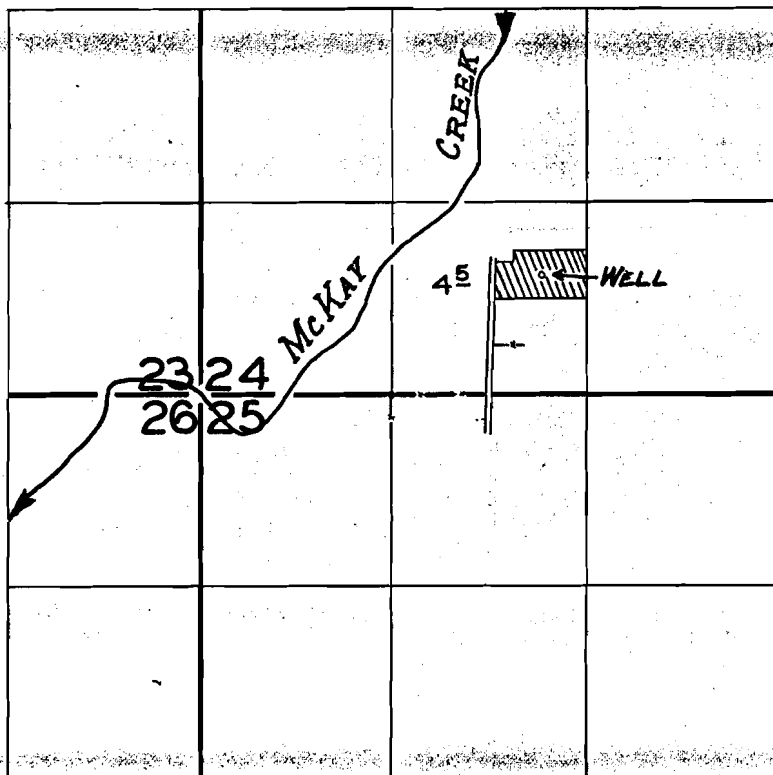

## FINAL PROOF SURVEY UNDER

Application No. G.1130 Permit No. G.1220  
IN NAME OF

GEORGE P. COOK

Surveyed OCT. 8, 1960, by M. BISH