


22 23
27 26

**FINAL PROOF
WATER RIGHTS MAP**
UNDER PERMIT 52329


SW 1/4 SW 1/4, SEC. 23, T 19 S, R 12W, W.M.
DUNES CITY, LANE COUNTY, OREGON.

FOR: **ROBERT G. CRIPPEN**
P.O. BOX 2616
FLORENCE, OR 97439

PREPARED BY: **WOBBE & ASSOCIATES, INC.**
510 KINGWOOD ST. / P.O. BOX 3093
FLORENCE, OR 97439
DATE DECEMBER 19, 1996

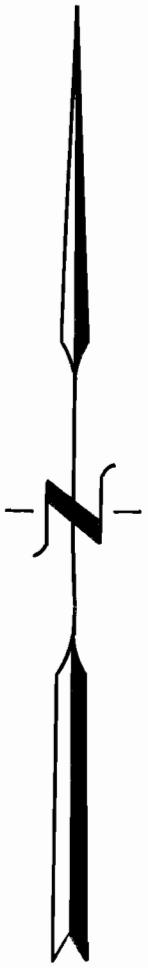

SCALE
1" = 400'

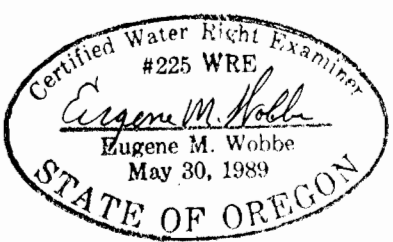

12/9/96

THIS MAP IS FOR THE PURPOSE OF IDENTIFYING THE LOCATION OF THE WATER RIGHT ONLY. THERE IS NO INTENT TO PROVIDE DIMENSIONS OR LOCATIONS OF PROPEPTY OWNERSHIP LINES.