


T. 14 S., R. 13 E., W.M.

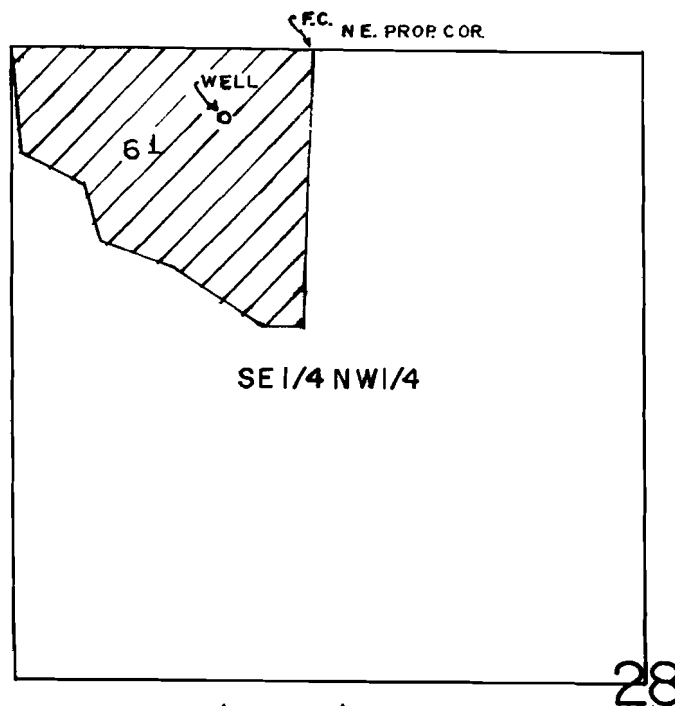

WELL LOC: 150' S. & 440' E. FROM NW COR. OF
SE 1/4 NW 1/4 OF SEC 28.

SCALE: 1" = 400'

FINAL PROOF SURVEY
UNDER

Application No. G-5487 Permit No. G-5391
IN NAME OF

BAILEY, CLARENCE J.L.

Surveyed MAY 26, 1992, by B.W. BISHOP