


T. 8 S., R. 42 E., W.M.

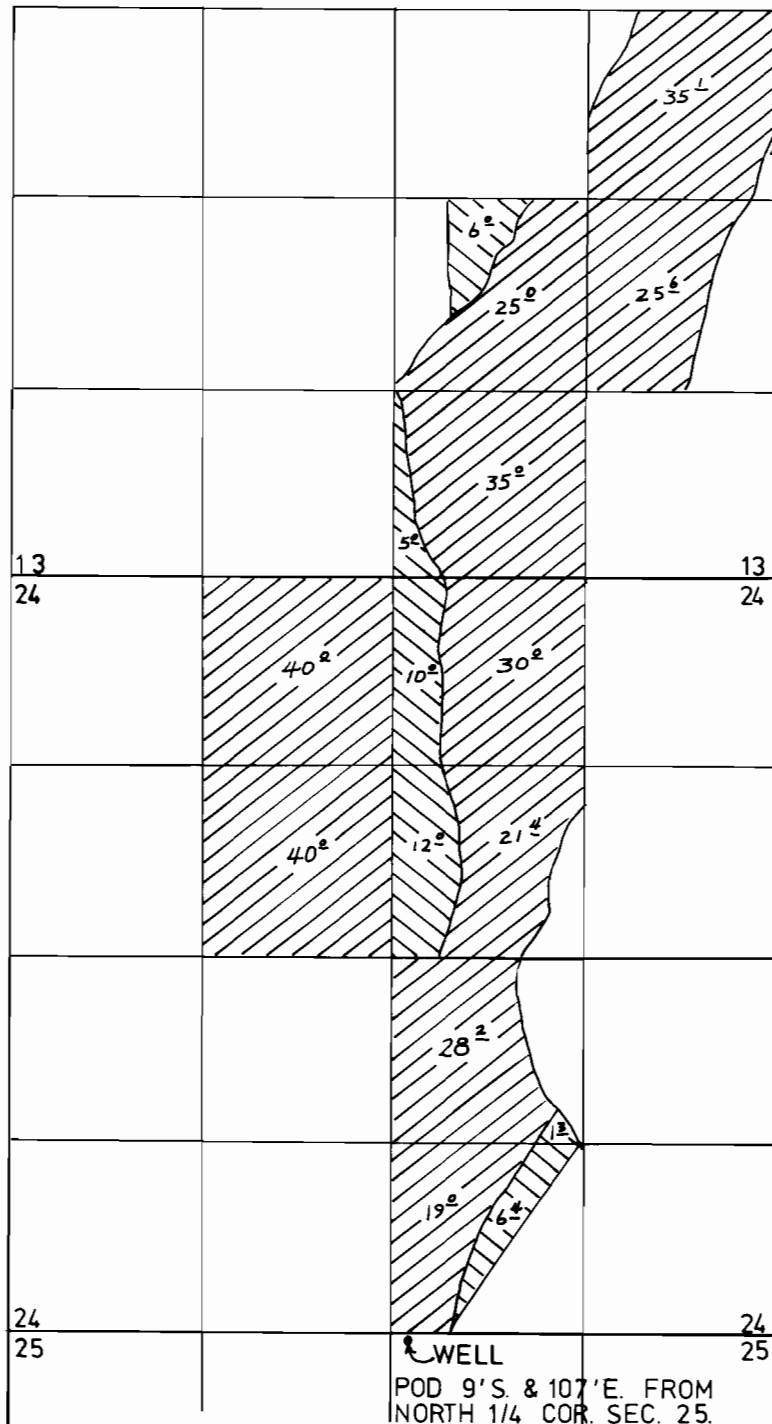

N
1" = 1320'

PRIMARY
SUPPLEMENTAL

FINAL PROOF SURVEY UNDER

Application No. G-7717 Permit No. G 7753
IN NAME OF

R. ALAN HUNT

Surveyed 5-14, 1992, by J. MILLER