


T. 14 S., R. 43 E., W.M.

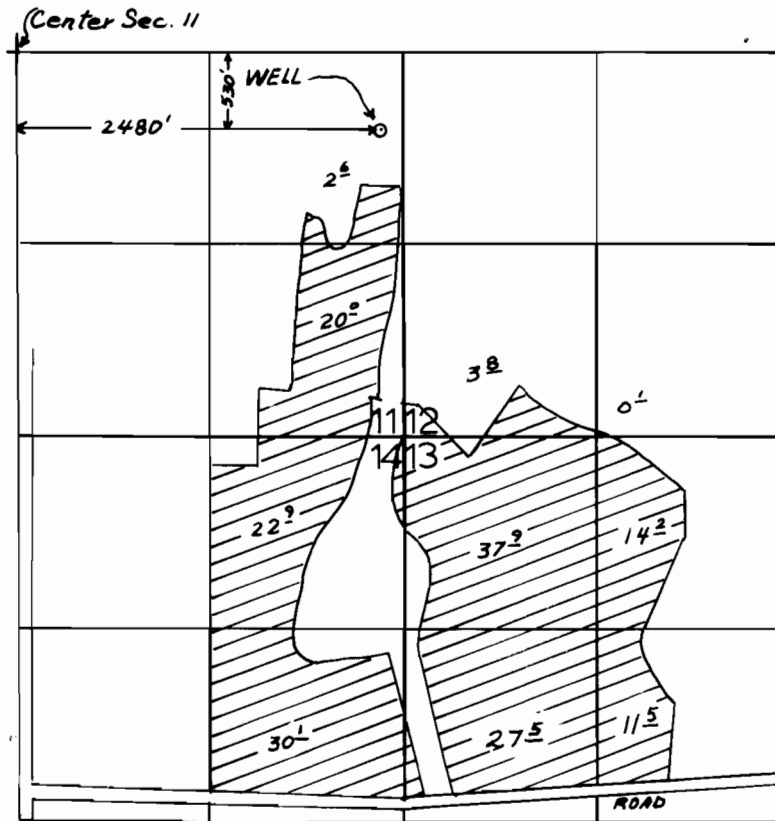

FINAL PROOF SURVEY UNDER

Application No. G-9378 Permit No. G 8839
IN NAME OF

JACK HARRIS

Surveyed 7-26, 1994, by J. MILLER