


# T. 13 S., R. 12 E. W.M.

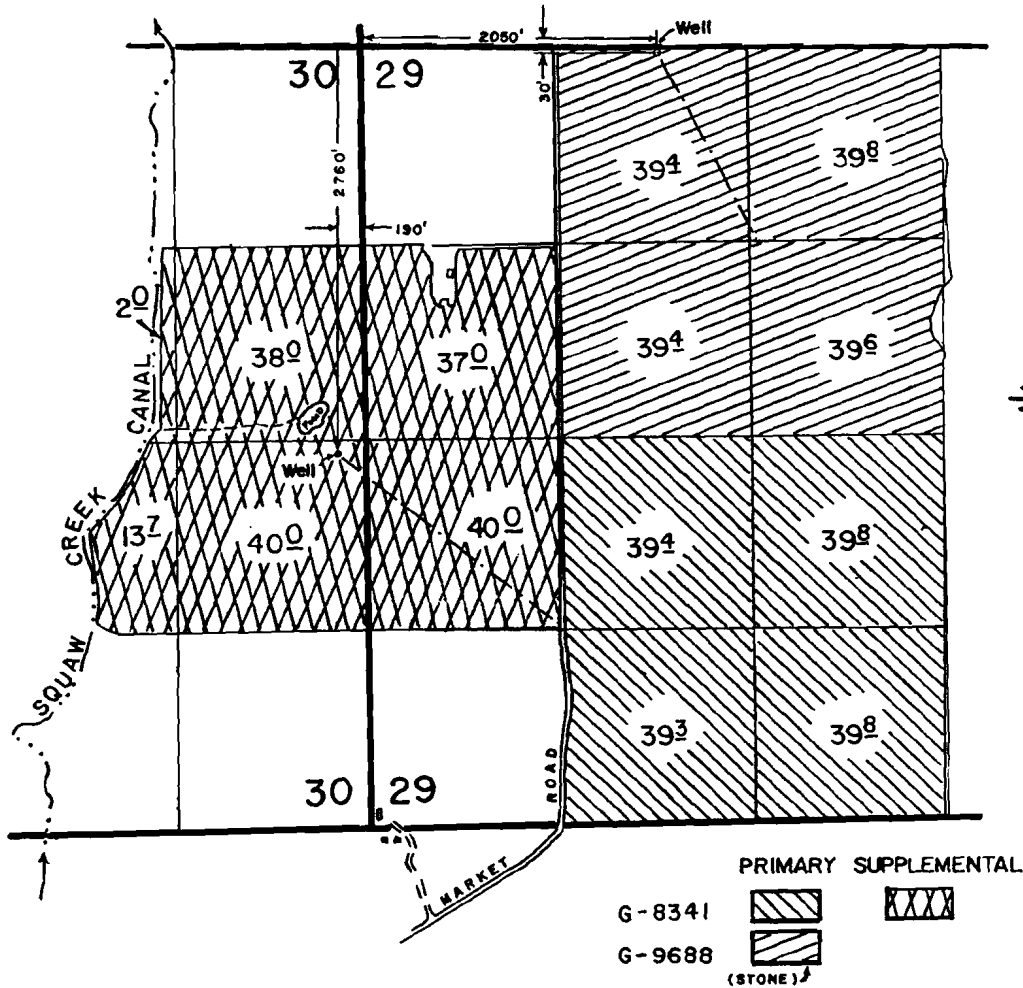

SCALE: 1" = 1,320'

## FINAL PROOF SURVEY UNDER

G-8763                      G-8341  
Application No. G-10453      Permit No. G-9688...  
IN NAME OF

BENJAMIN E. DAVIS and RICHARD J. & LEE L. STONE

Surveyed Sept. 16 19 87, by M. MATTICK....