

POINT OF DIVERSION (WELL)
 LOCATED: 125' SOUTH AND 2060' EAST FROM
 THE (PROJECTED) NW CORNER OF SECTION 27,
 WITHIN THE NE 1/4 NW 1/4 OF SECTION 27, T2S,
 R1E, WM, CLACKAMAS COUNTY, OREGON

THIS MAP IS FOR THE PURPOSE OF
 IDENTIFYING THE LOCATION OF THE
 WATER RIGHT ONLY AND IS NOT INTENDED
 TO PROVIDE LEGAL DIMENSIONS OR
 LOCATION OF PROPERTY OWNERSHIP LINES.


SURVEYED BY:

AREA OF BENEFICIAL USE
 LOCATED IN T2S, R1E, WM,
 CLACKAMAS COUNTY, OREGON



SECTION 27, W 1/4 NW 1/4

SECTION 28, E 1/4 NE 1/4

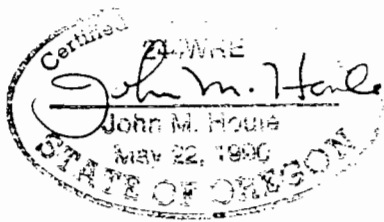

3898

FINAL PROOF SURVEY
 UNDER APPLICATION G-11154, PERMIT G-10270
 (ASHDOWN WOOD)

APPLICANT: ASHDOWN WOOD WATER COMPANY
 P.O. BOX 211
 LAKE OSWEGO, OREGON 97034 (503)636-0424
 MARCH 6, 1992

otak
 INCORPORATED
 17355 SW BOONES FERRY RD.
 LAKE OSWEGO, OR. 97035
 (503) 635-3618