


T. 3 S., R. 1 E., W.M.

RECEIVED

NOV 25 1998

WATER RESOURCES DEPT.
SALEM, OREGON

T-8121

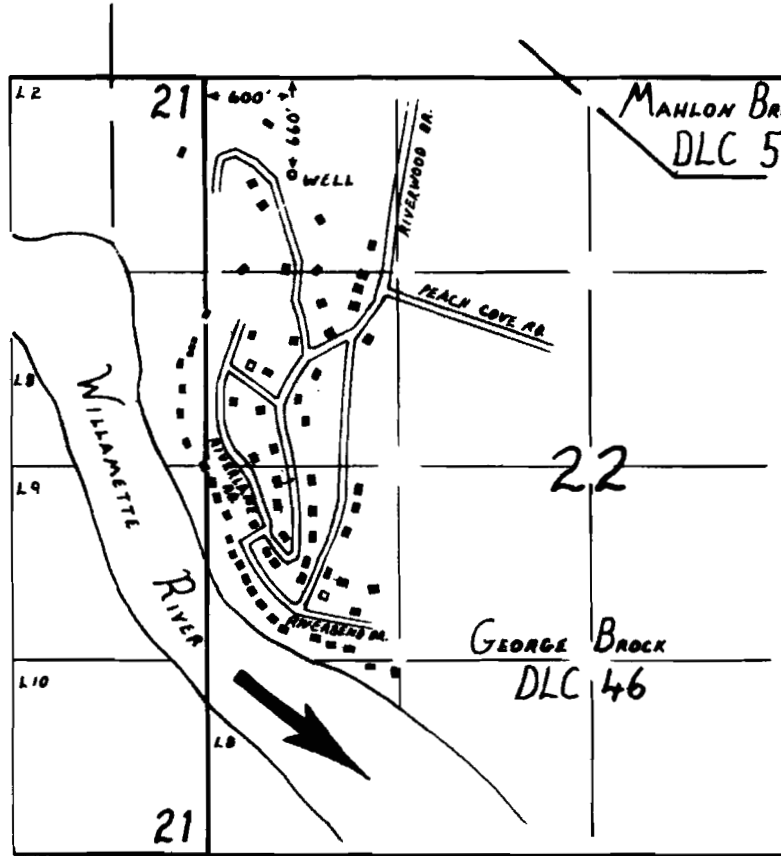

FINAL PROOF SURVEY

UNDER

Application No. G-11591 Permit No. G-10678
IN NAME OF

RIVERBEND-RIVERBANK WATER IMPROVEMENT DISTRICT

Surveyed NOVEMBER 25, 1992, by R.W. Klassen

- HOUSE
- COMMUNITY CENTER BUILDING