





FINAL PROOF SURVEY MAP

IN THE NAME OF DEE R. PEREIRA

1 INCH = 400 FEET

SECTION 6, T26S, R5W, W.M.
APPLICATION G-11708 PERMIT G-10823

ROGERS ROAD

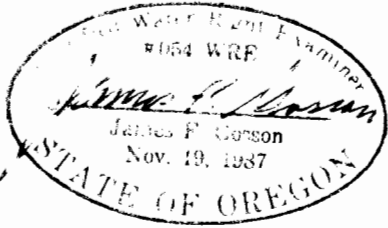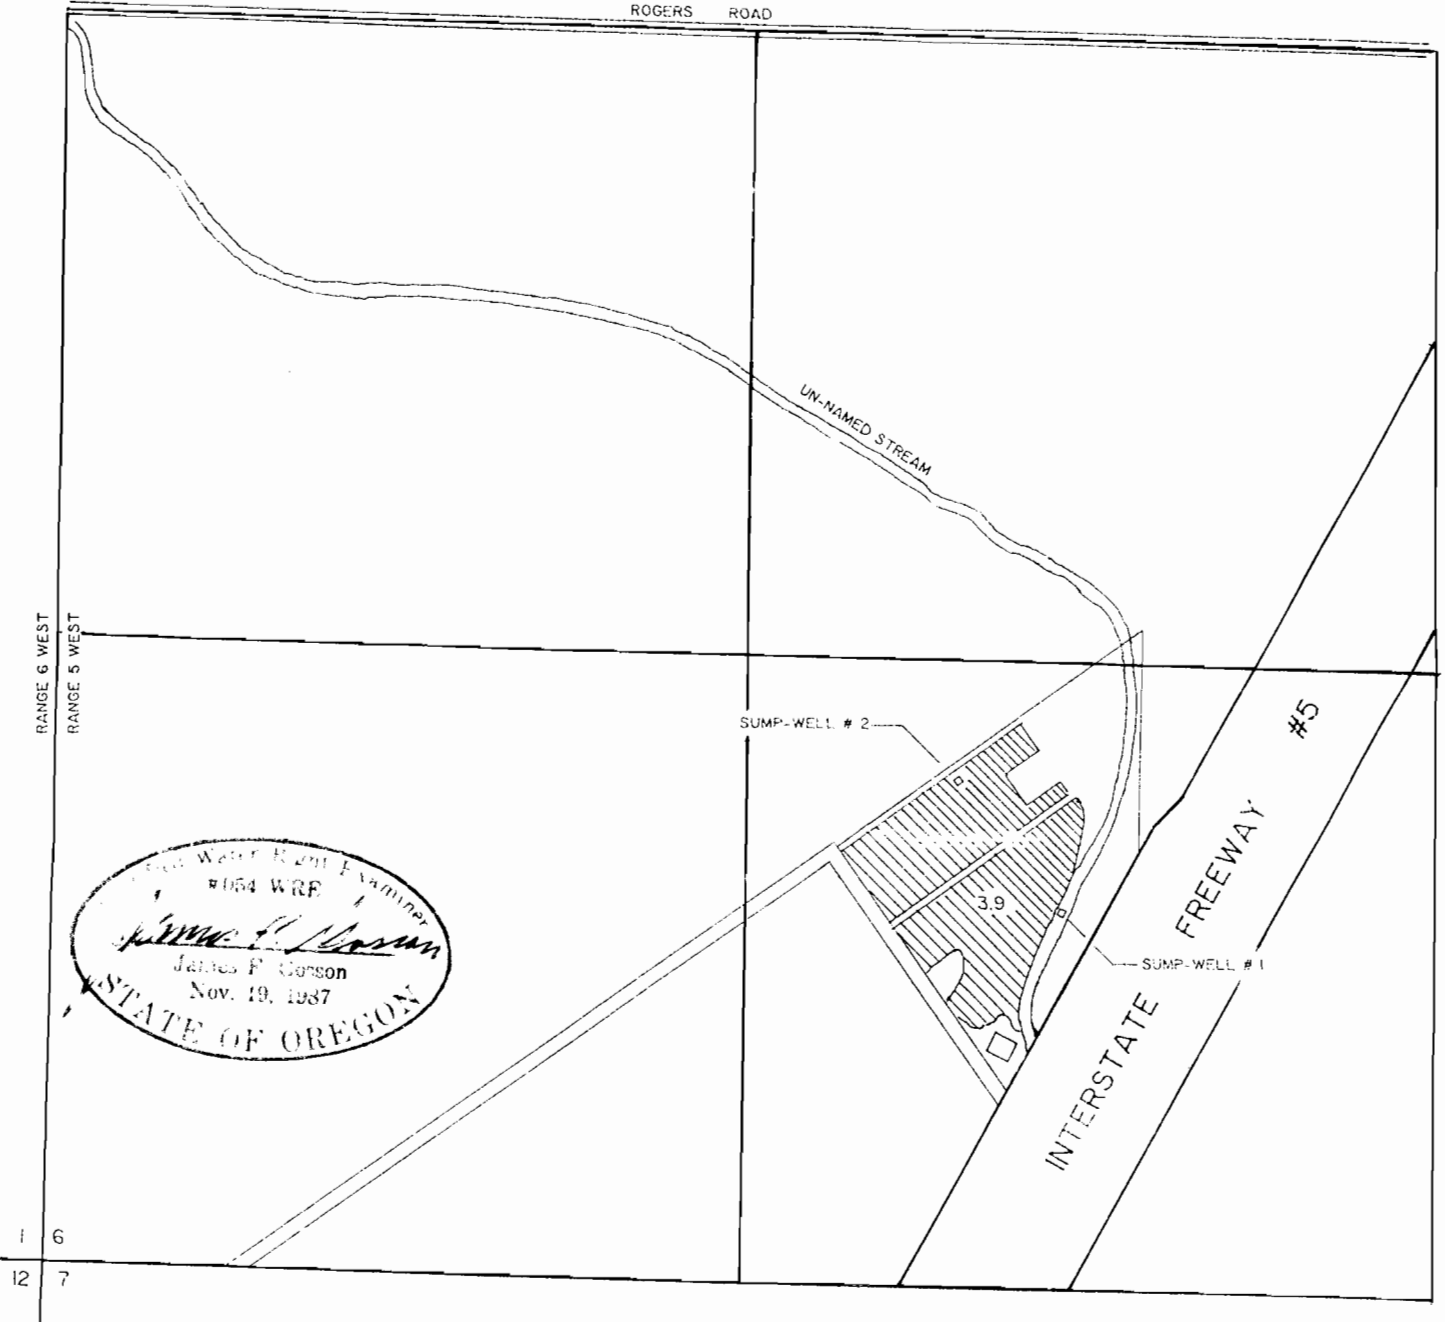

SUMP WELL #1 IS LOCATED 780 FEET NORTH AND 2100 FEET EAST FROM THE SOUTHWEST CORNER OF SECTION 6.

SUMP WELL #2 IS LOCATED 1050 FEET NORTH AND 1870 FEET EAST FROM THE SOUTHWEST CORNER OF SECTION 6. BOTH SUMP WELLS BEING WITHIN THE SE1/4 SW1/4 OF SECTION 6. TOWNSHIP 26 SOUTH, RANGE 5 WEST, W.M., DOUGLAS COUNTY.

THE PURPOSE OF THIS MAP IS TO IDENTIFY THE LOCATION OF THE WATER RIGHT. IT IS NOT INTENDED TO PROVIDE INFORMATION RELATIVE TO THE LOCATION OF PROPERTY OWNERSHIP BOUNDARY LINES.