


T2S., R2W., W.M.

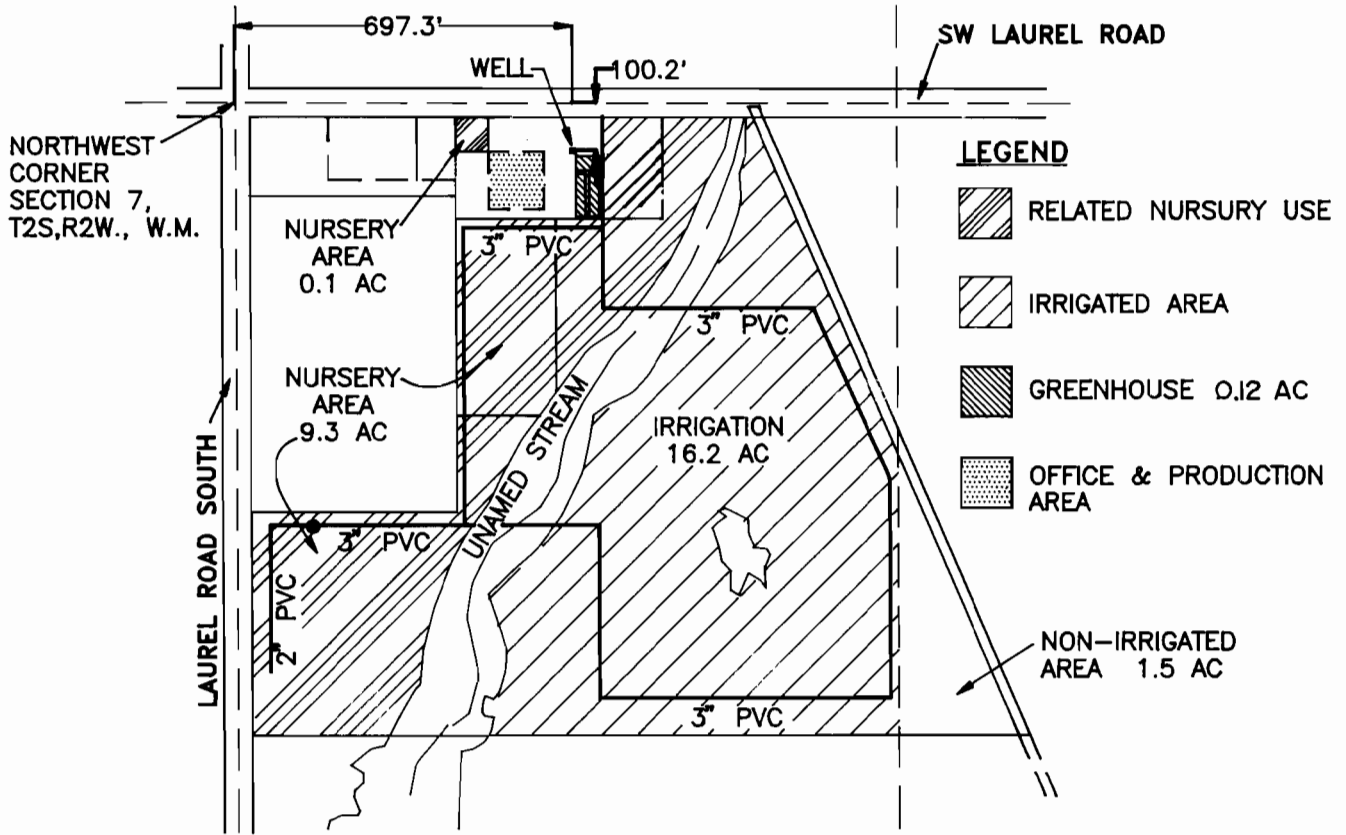

FINAL PROOF SURVEY


UNDER

Application No. G-11843 Permit No. G-10884

IN NAME OF

SIDNEY & HELEN MIRSKY

Surveyed 08/19/94, by A.M. KLEIN

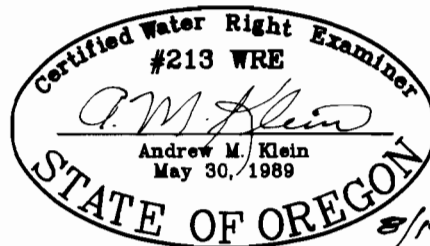

SCALE: 1" = 400'

EXPIRES 06/30/95

THIS MAP IS FOR THE PURPOSE OF IDENTIFYING THE LOCATION OF THE WATER RIGHT ONLY AND IS NOT INTENDED TO PROVIDE LEGAL DIMENSIONS OR THE LOCATION OF PROPERTY OWNERSHIP LINES