


FINAL PROOF SURVEY

LOCATED IN SECTION 18, T.21S., R.20E., W.M.,
DESCHUTES COUNTY, OREGON

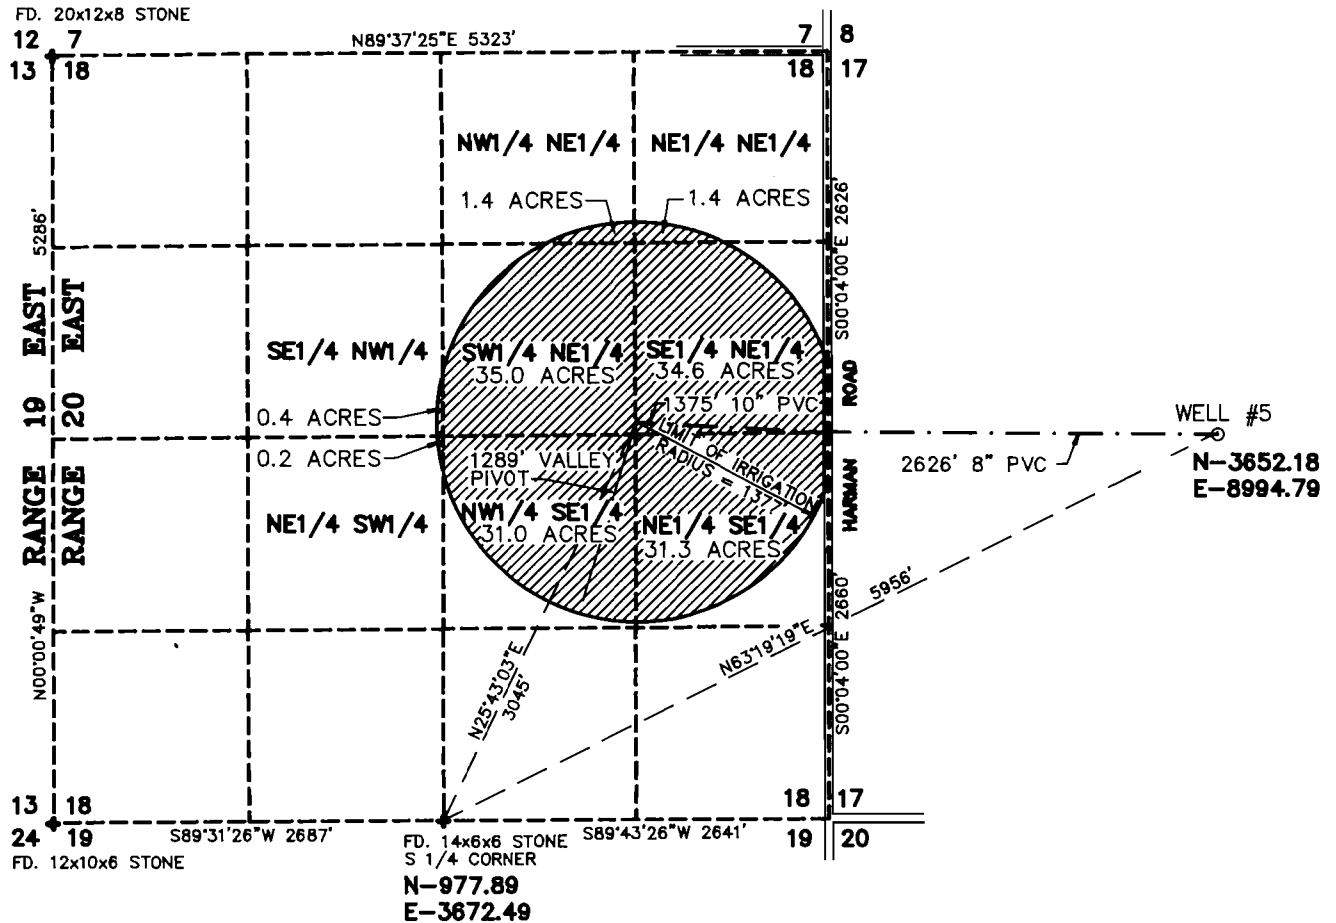


PERMITTEE:

ROBERT L. COATS
63285 SKYLINE RANCH ROAD
BEND, OREGON 97709

USE:

IRRIGATION

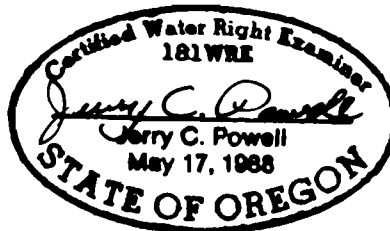

LEGEND:

- WELL
- · — PIPELINE
- PERMIT No. 11002



SCALE: 1" = 1320'

THIS MAP IS FOR THE PURPOSE OF LOCATING A
WATER RIGHT AND IS NOT INTENDED TO PROVIDE
LEGAL DIMENSIONS FOR PROPERTY BOUNDARIES.



DAVID EVANS AND ASSOCIATES, INC
709 NW WALL STREET, SUITE 102
BEND, OREGON 97701 (503)389-7614

**WATER RIGHTS MAP
FOR
ROBERT L. COATS**

scale	1" = 1320'	design
date	5/21/91	drawn
file	WREX005	