


RECEIVED

SEP 23 1996

WATER RESOURCES DEPT.
SALEM, OREGON

T.14 S., R.43 E., W.M.

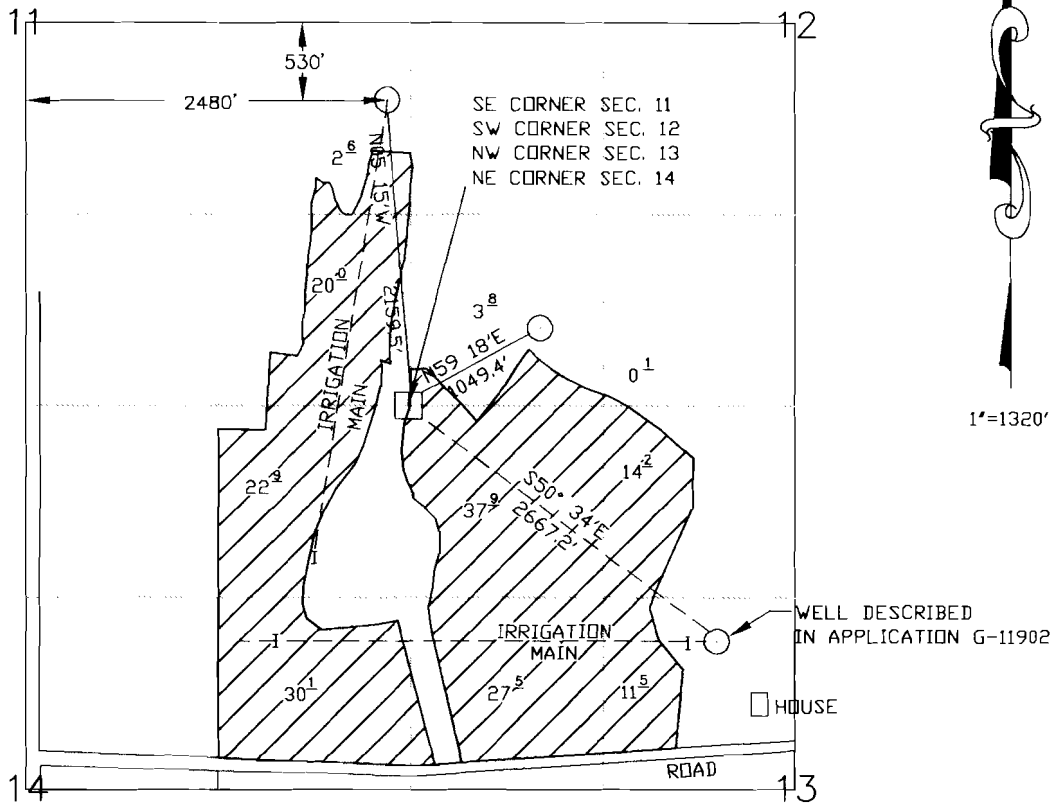

FINAL PROOF SURVEY
UNDER

Application No. G-11902 Permit No. G-11015
IN NAME OF

JACK HARRIS

Surveyed 7-26, 1994, by J. MILLER
WATER RESOURCES DEPARTMENT

170.6 ACRES

UNDER APPLICATION G-9378 PERMIT G-8839

FINAL PROOF SURVEY DONE BY HOLLADAY ENGINEERING CO.

Surveyed 7-29 1996 by M. HOLLADAY

THIS MAP IS FOR THE PURPOSE OF IDENTIFYING THE LOCATION OF
WATER RIGHTS ONLY AND IS NOT INTENDED TO PROVIDE LEGAL
DIMENSIONS OR LOCATION OF PROPERTY LINES.