79414

# T. 16 S., R. 12 E., W.M.

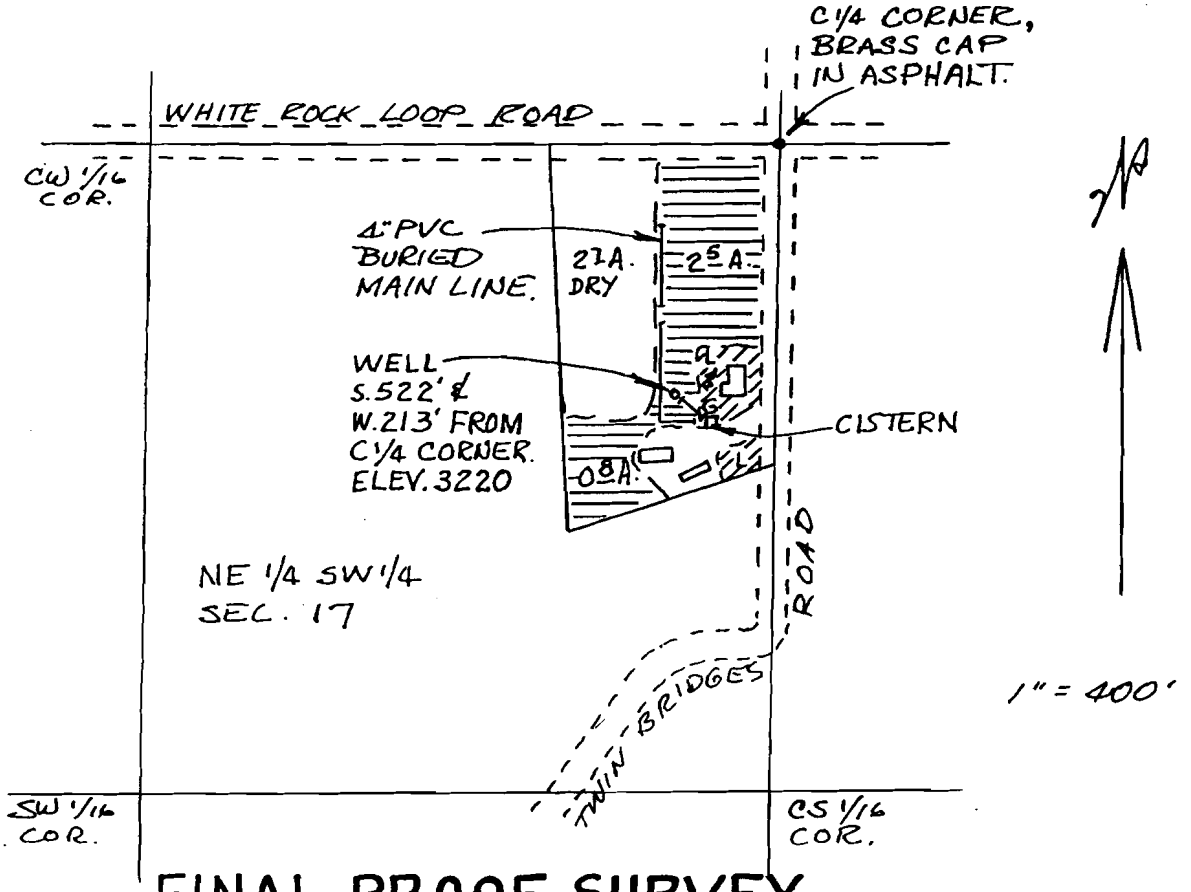


## FINAL PROOF SURVEY

UNDER PERMIT NO. G-11018
IN NAME OF
DELMAR EUGENE DAVIS
AND

TERRY ELLEN DAVIS

SURVEYED 11 JAN. 1991
BY R. E. OMAN

| | |
|---|---|
| PASTURE | 3.3 AC. |
| LAWN & GARDEN | 0.3 AC. |
| IN ALL, | 3.6 AC. |

THIS PLAT IS MADE FOR WATER RIGHTS ESTABLISHMENT OR TRANSFER AND DOES NOT CONSTITUTE A BOUNDARY SURVEY PLAT UNDER O.R.S. 92, 94 OR 209.

Certified Water Right Examiner #096
Raymond E. Omer
Nov. 19, 1987
STATE OF OREGON

RECEIVED
MAY 29 1991
WATER RESOURCES DEPT
SALEM, OREGON

G-11018