

RECEIVED

JUN 19 2001

WATER RESOURCES DEP  
SALEM OREGON


*Claim of Beneficial Use*  
in the name of  
Frank E. and Julie E. Rodreick

Permit No. G12809  
Application file No. G13911

Township 39 South of Range 3 West  
Willamette Base & Meridian  
Jackson County, Oregon

Section 28  
SW 1/4 of SW 1/4

Section 28  
SE 1/4 of SW 1/4

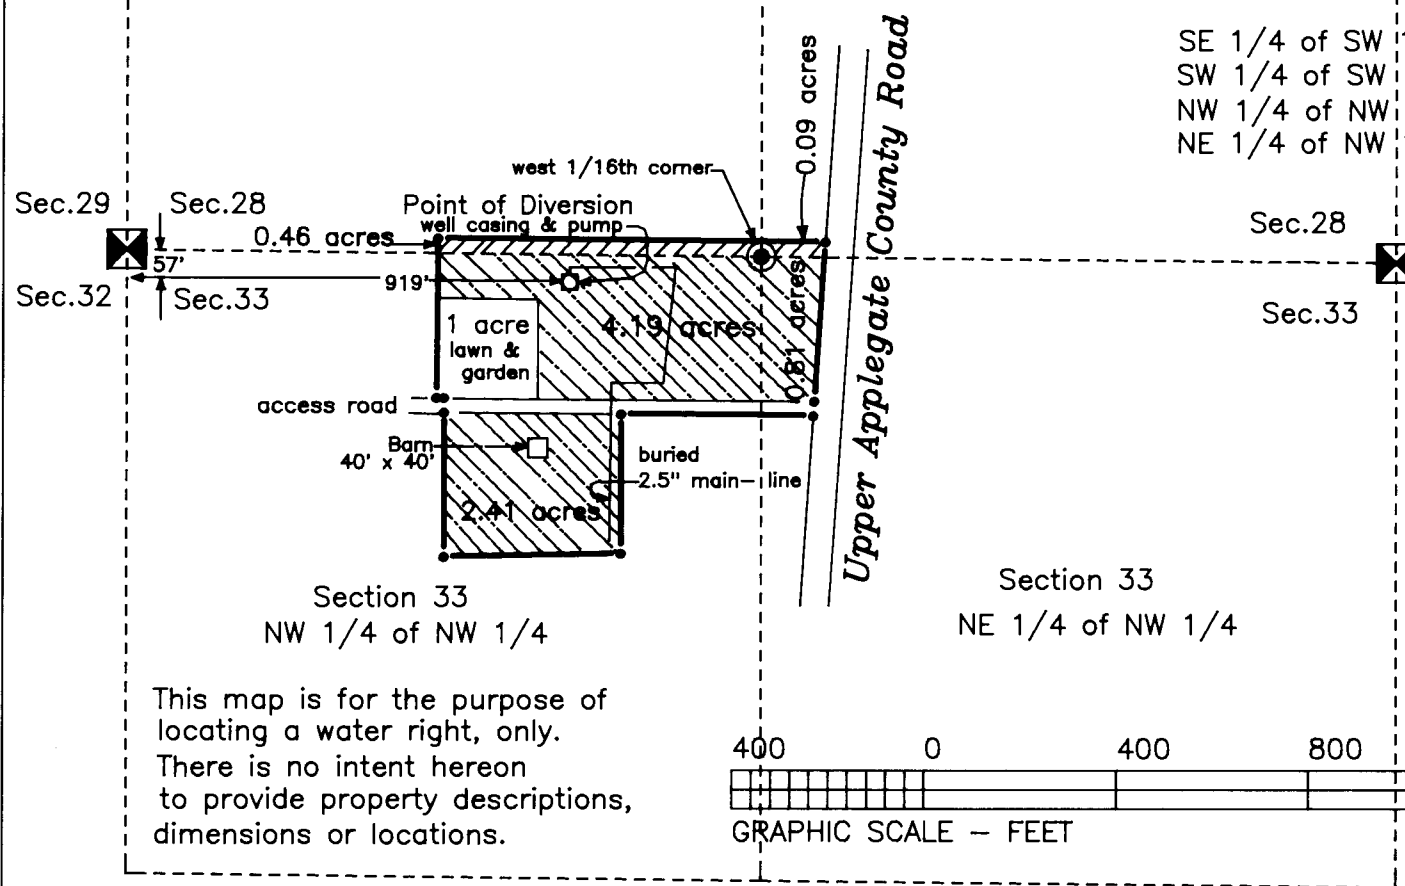


SE 1/4 of SW 1/4 Section 28	0.09 acres
SW 1/4 of SW 1/4 Section 28	0.46 acres
NW 1/4 of NW 1/4 Section 33	6.60 acres
NE 1/4 of NW 1/4 Section 33	0.81 acres

total acreage 7.96 acres

Sec.28 One-Quarter Corner

Sec.33

*Certified Water Right Examiner*  
434WRE  
*Martin C. Stewart*  
Martin C. Stewart  
May 14, 1996  
STATE OF OREGON

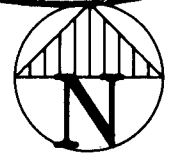

This map is for the purpose of locating a water right, only. There is no intent hereon to provide property descriptions, dimensions or locations.

