


T. 8 S., R. 1 E., W. M.

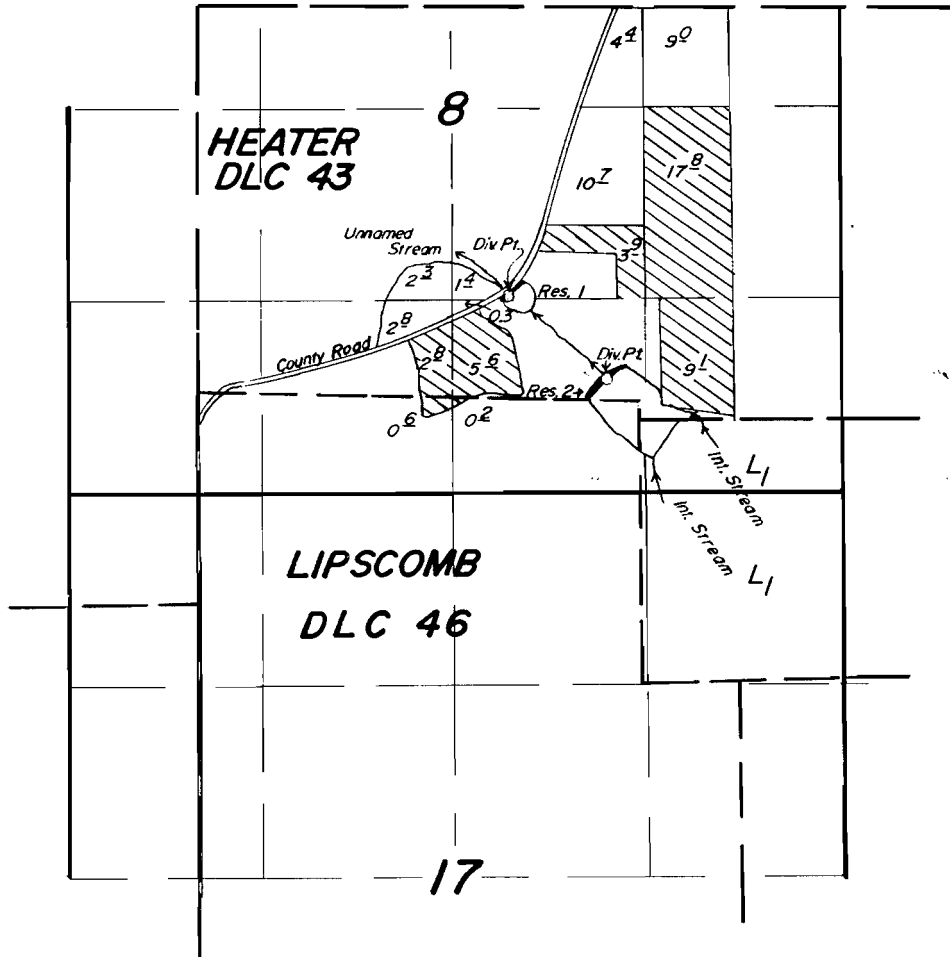

Div. Pt. 1 Loc.: 30' N. & 390' E.
 Div. Pt. 2 Loc.: 550' S. & 1050' E.
 both from NW Cor. of SW 1/4 SE 1/4 Sec. 8.

1" = 1320'

FINAL PROOF SURVEY

UNDER

R 59816
 59817

R 8149
 44946

R 55386

R 6699

Application No. 55387 Permit No. 42324

IN NAME OF

JAMES M. HEATER

Surveyed Nov. 11, 1984, by Peter Pagter &

Nov. 18, 1984, by Ben Bishop