


RECEIVED

MAR 13 1977

WATER RESOURCES DEPT.
SALEM, OREGON

1" = 400'

SEE MAP 39 5 11

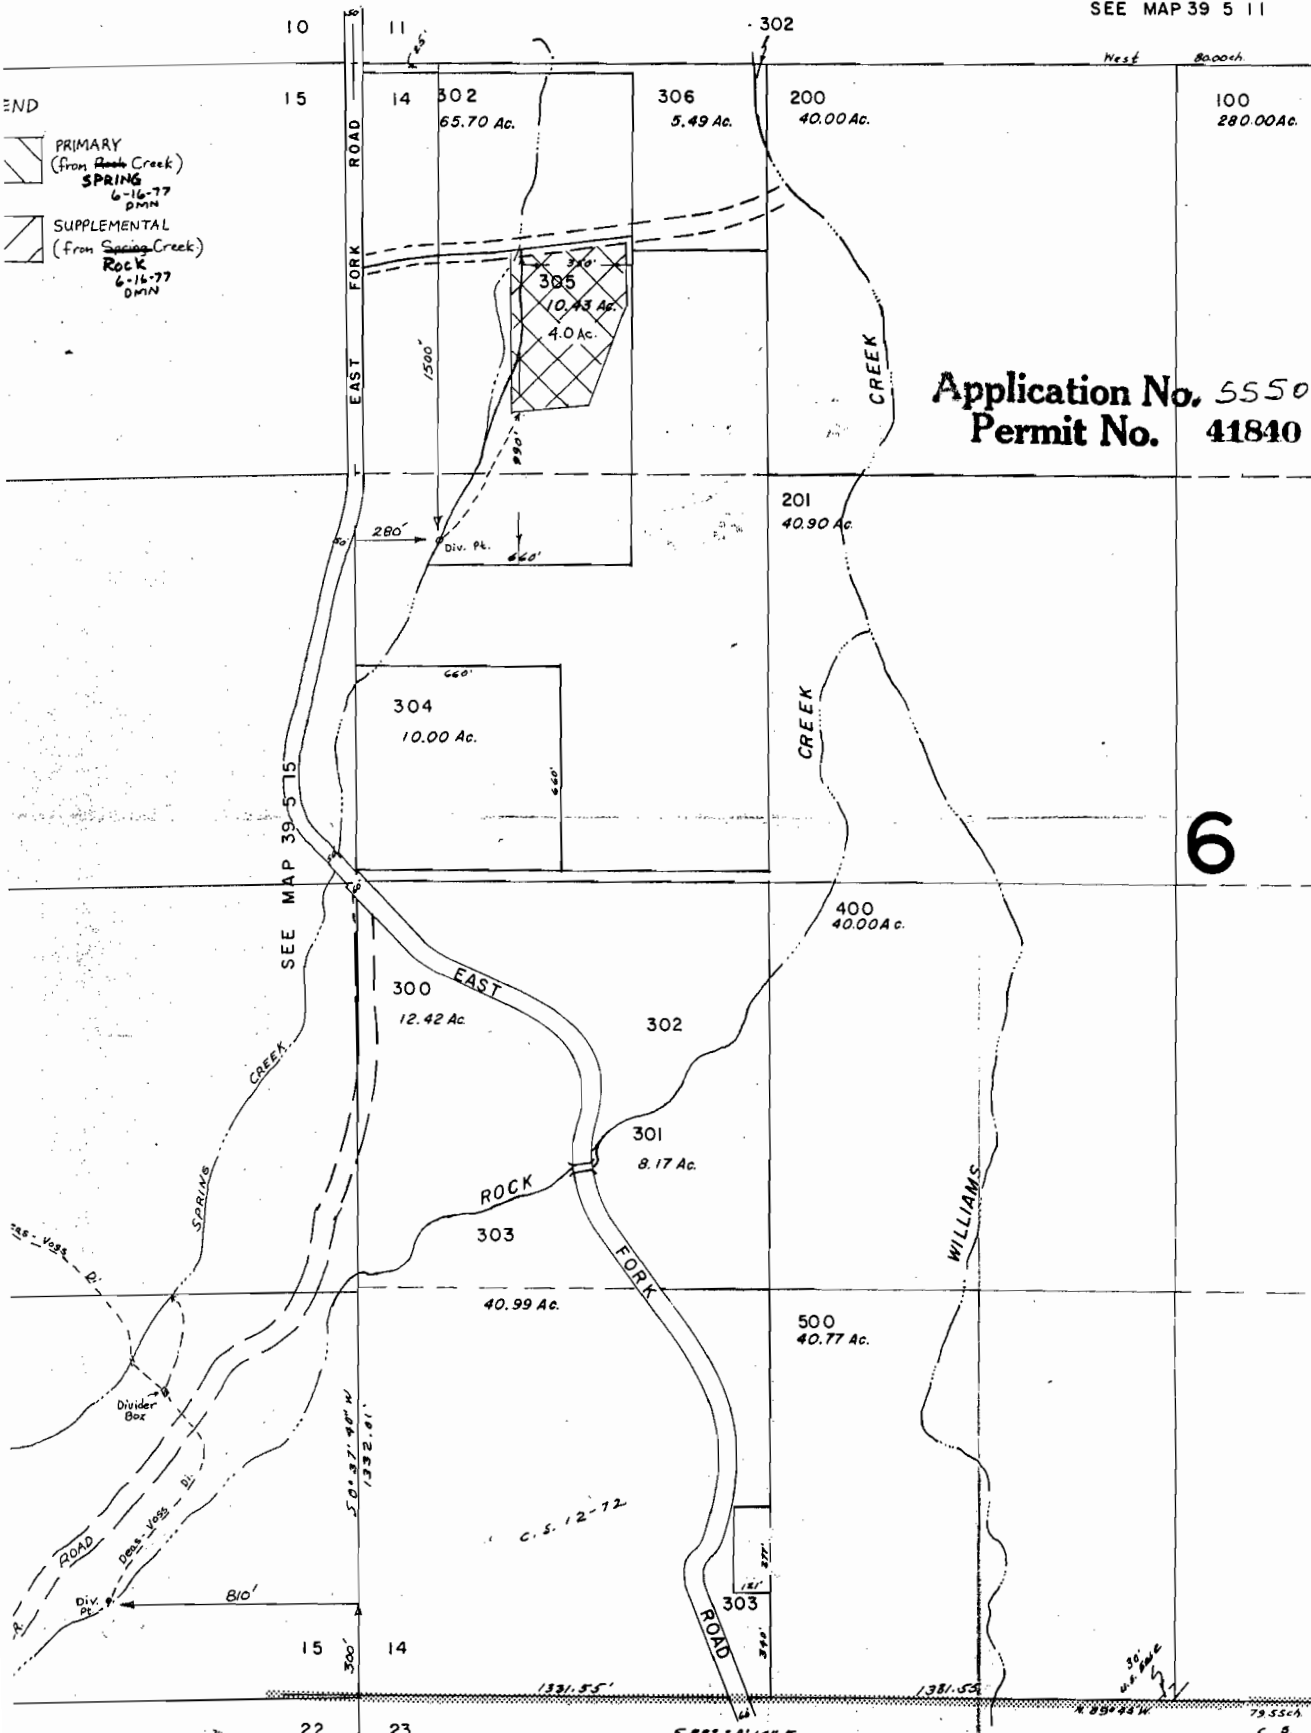

Application No. 55509
Permit No. 41840

6

SEE MAP 39 5 23