

# FINAL PROOF SURVEY

**RECEIVED**

APPLICATION No. S-71109

PERMIT No. 51735



OCT 01 1999

WATER RESOURCES DEPT.  
SALEM, OREGON

Applicant: Fleming Loving Trust  
PO Box 985  
Baker City, Oregon 97814



SCALE: 1" = 1320'

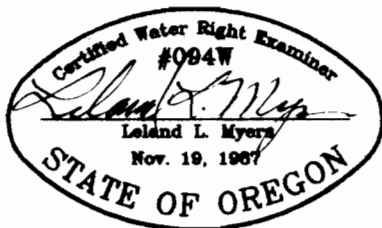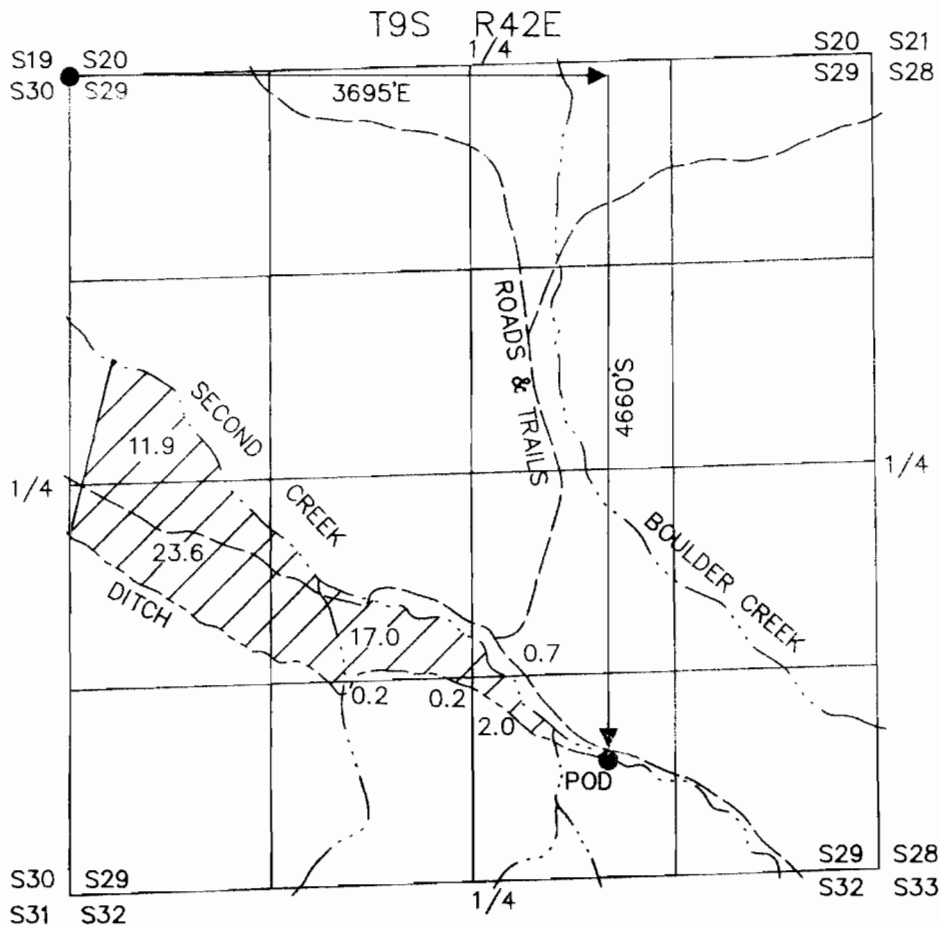

This map is for the purpose of identifying the location of the water right only and has no intent to provide dimensions or location of property ownership lines.