


FINAL PROOF
WATER RIGHTS MAP
 UNDER PERMIT NO. 51607
 APPLICATION NO. 71767

NW 1/4 NE 1/4, SEC. 27, T 17 S, R 10 W, W.M.
 LANE COUNTY, OREGON.

FOR: DONALD R. HEMAN AND MARY JANE HEMAN
 11812 HWY. 36
 MAPLETON, OR 97453

PREPARED BY: WOBBE & ASSOCIATES, INC.
 510 KINGWOOD ST.
 P.O. BOX 3093
 FLORENCE, OR 97439
 JUNE 6, 1997

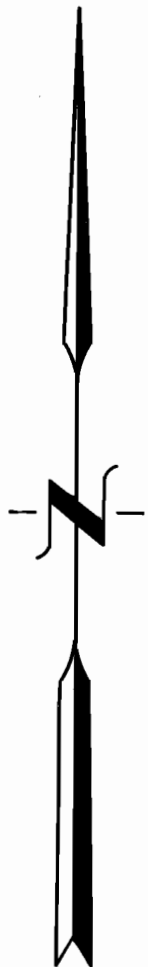

SCALE
 1" = 400'