



T.7N., R.10W., W.M.
SECTION 10

4 | 3
9 | 10
SEC. CORNER

RECEIVED

SEP 05 2001

WATER RESOURCES DEPT.
SALEM, OREGON

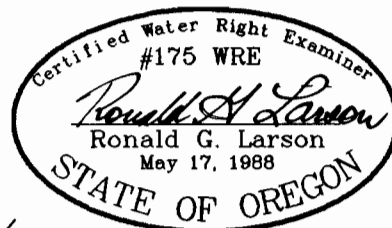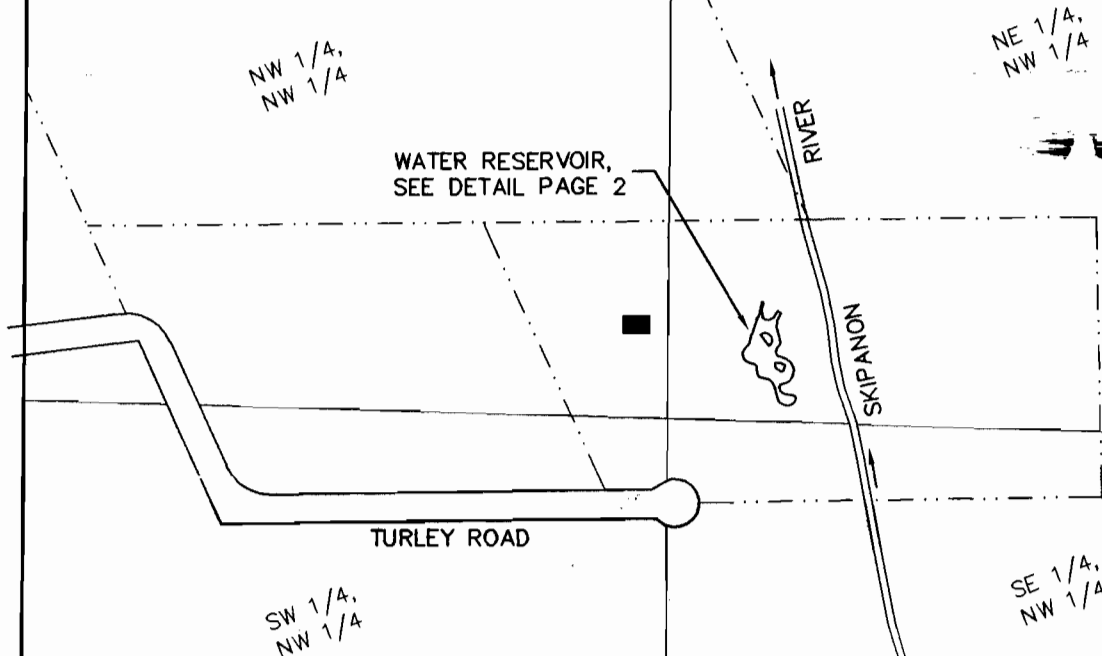

RENEWAL DATE: DECEMBER 31, 2002



SCALE:
1" = 400'

FINAL PROOF SURVEY

UNDER

APPLICATION NO. R-80139, PERMIT NO. R-12195

IN THE NAME OF

JAMES B. SCHELLER

SURVEYED AUG. 8, 2001

FILE: 4425-7824-01-01.DWG

HLB & ASSOCIATES, INC.
SURVEYING • ENGINEERING • PLANNING

160 LANEDA AVE.
MANZANITA, OR 97130
(503) 368-5394
FAX: (503) 368-5847

4253A HWY 101 N.
SEASIDE, OR 97138
(503) 738-3425
FAX: (503) 738-7455