

FINAL PROOF MAP  
SECTION 1, T.27S. R.17E., W.M.  
LAKE COUNTY, OREGON

Tax Lots 1200 & 1500

LARRY & TARA GRASSMAN  
T-7615


RECEIVED

JAN 10 1999


WATER RESOURCES DIV.  
SALEM, OREGON



SCALE  
1" = 1320'

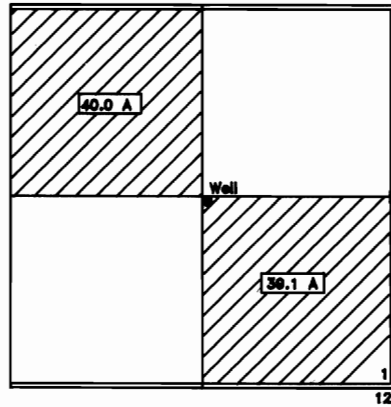

S 1/16  
1/2" Iron pin  
Well is located S89°17'57"W  
1325.60' from the NE corner  
of the SE 1/4 SE 1/4

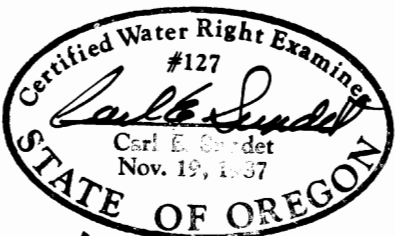

Renews 6/30/00

Prepared by: Sundet & Associates  
P.O. Box 1228  
Lakeview, OR 97630  
(541) 947-3293  
Dr. #9698

This map is for the purpose of identifying the location of the water right only and is not intended to provide legal dimensions or location of property ownership lines.