


T.15S. R.7 W.W.M.

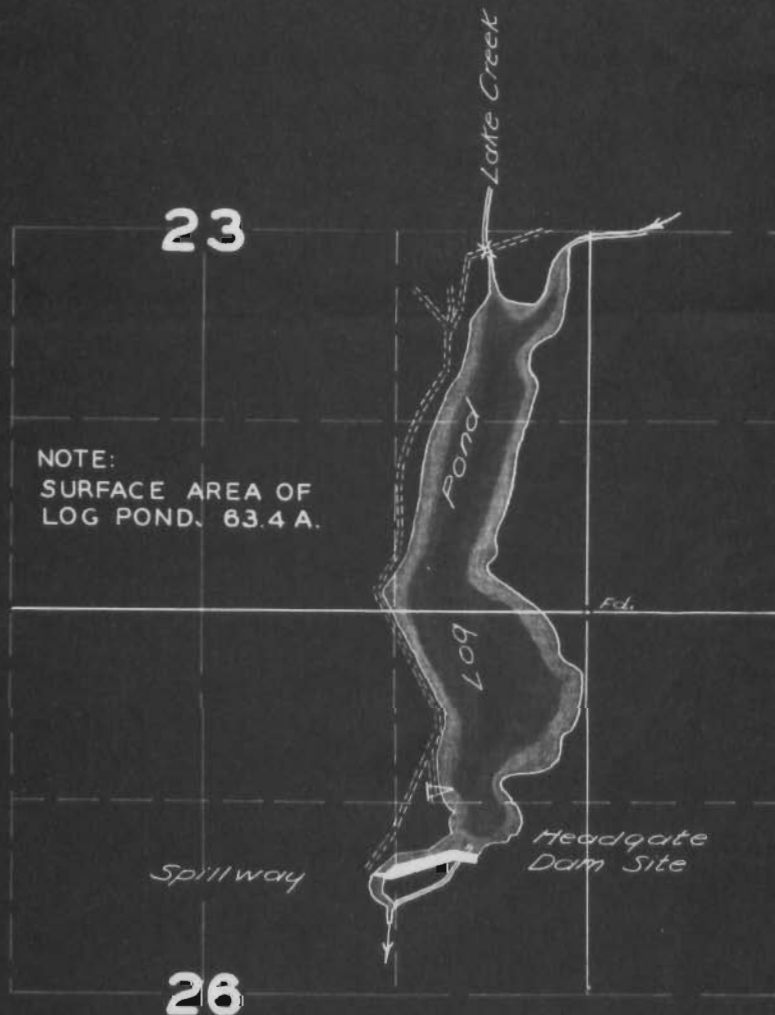

FINAL PROOF SURVEY

UNDER

23352

18545

Application No. R-23351 Permit No. R-965

IN NAME OF

HULT LUMBER CO.

Surveyed MAY 9, 1950, by H.L. COFFMAN