RECEIVED

JAN 1 3 2003


on No. 6 7147

T.38S., R.IIE., W.M.

RECEIVED

OCT2 91975

WATER RESOURCES DEPT. SALEM, OREGON

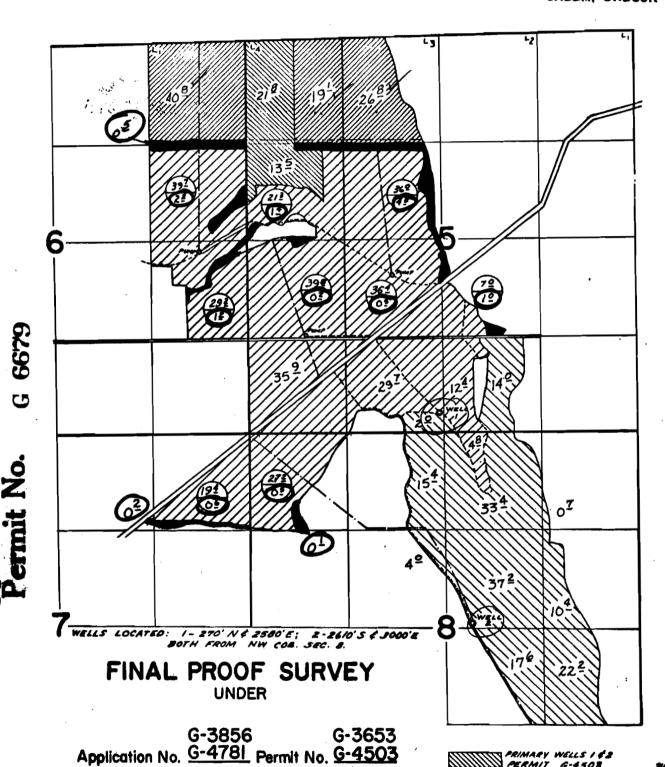

Surveyed Oct. 29 1974, by D.M.Norby

IN NAME OF ESTATE OF LEONARD RITTER AND JULIA RITTER PRIMARY SUPPLEMENTAL

new lands

CM9-311-182