


T.2N.,R.10E.,W.M.

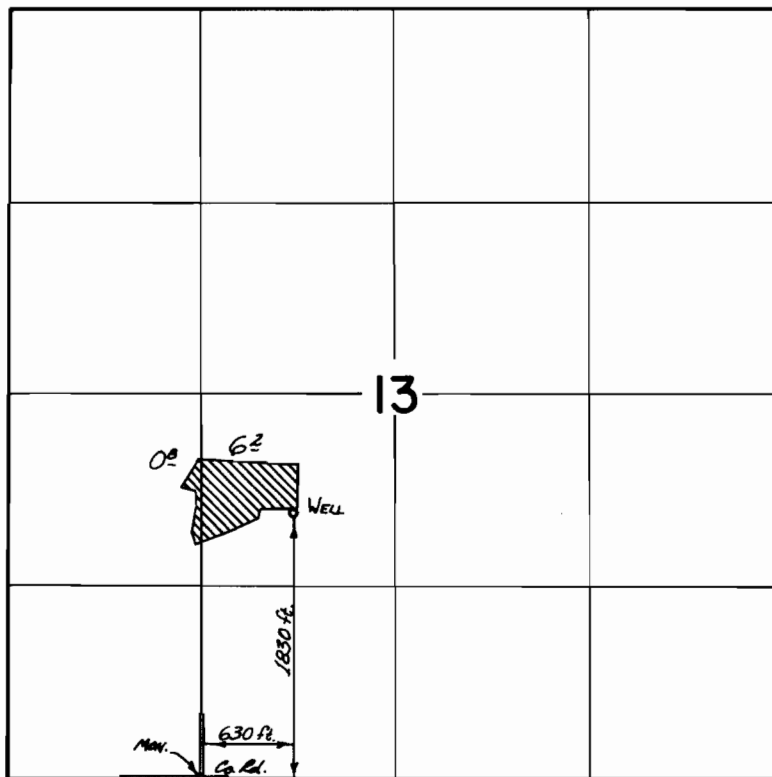

**FINAL PROOF SURVEY**  
UNDER

Application No. G-4562 Permit No. G-4286  
IN NAME OF

POOLEY ORCHARDS - M. S. WALTON

Surveyed Aug. 31, 1973, by D. Norby