


T36S, R2W, W.M.

JACKSON Co. OREGON

RECEIVED

JUL 14 1992

WATER RESOURCES DEPT.
SALEM, OREGON

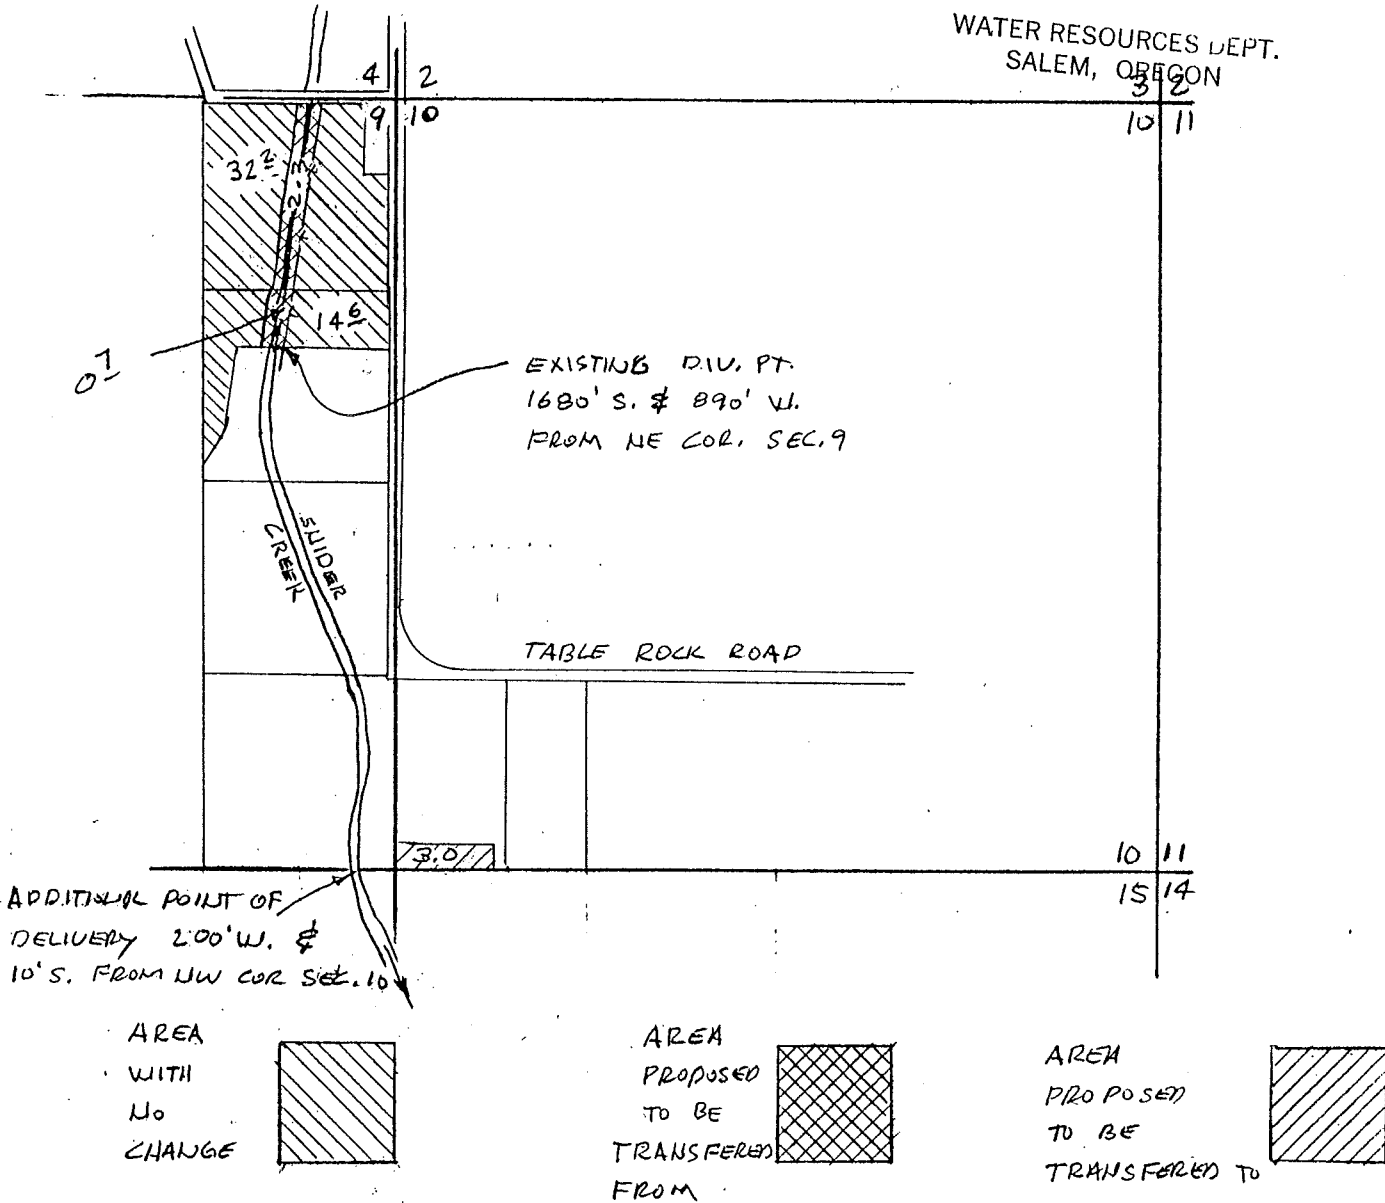


MAP TO ACCOMPANY AN APPLICATION FOR A CHANGE IN POINT OF DIVERSION AND A CHANGE IN PLACE OF USE

NOTE: MAP PREPARED FOR WATER RIGHT PURPOSES ONLY, NOT FOR PROPERTY BOUNDARY LOCATIONS

FOR: JACOB WOOD
11161 TABLE ROCK ROAD
CENTRAL POINT, OR, 97502


MAY 1, 1990 (REVISED JULY 2, 1992)

PREPARED BY:
GARY D. KAISER
KAISER SURVEYING
108 MISTLETOE ST.
MEDFORD, OR 97501

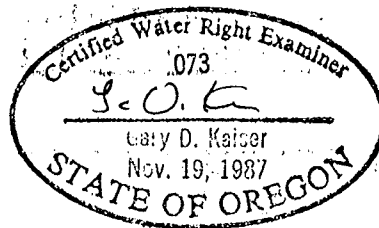

SCALE: 1" = 1/4 MILE

T.36S.R.2W.W.M.

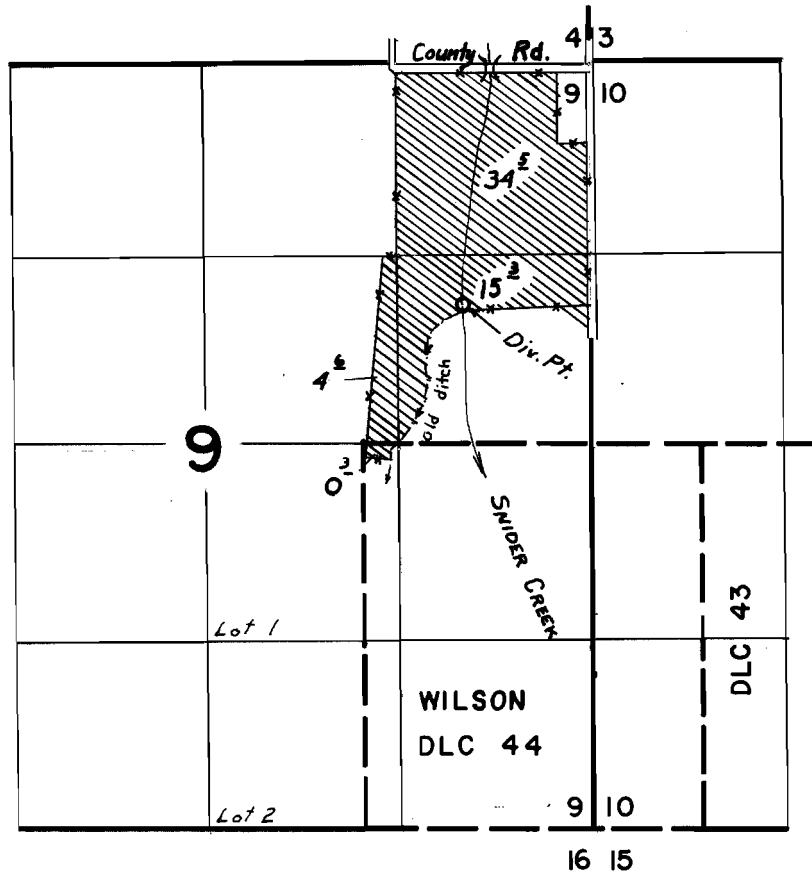

Div. Pt. located: 1680 ft. S. & 890 ft. W. from N.E. $\frac{1}{4}$ cor. Sec. 9.

FINAL PROOF SURVEY UNDER

Application No. 44345. Permit No. 33110
IN NAME OF

TABLE ROCK RANCH

Surveyed Jun. 3 1969, by L. E. Gould