



T. 23 S., R. 8 W. W.M.

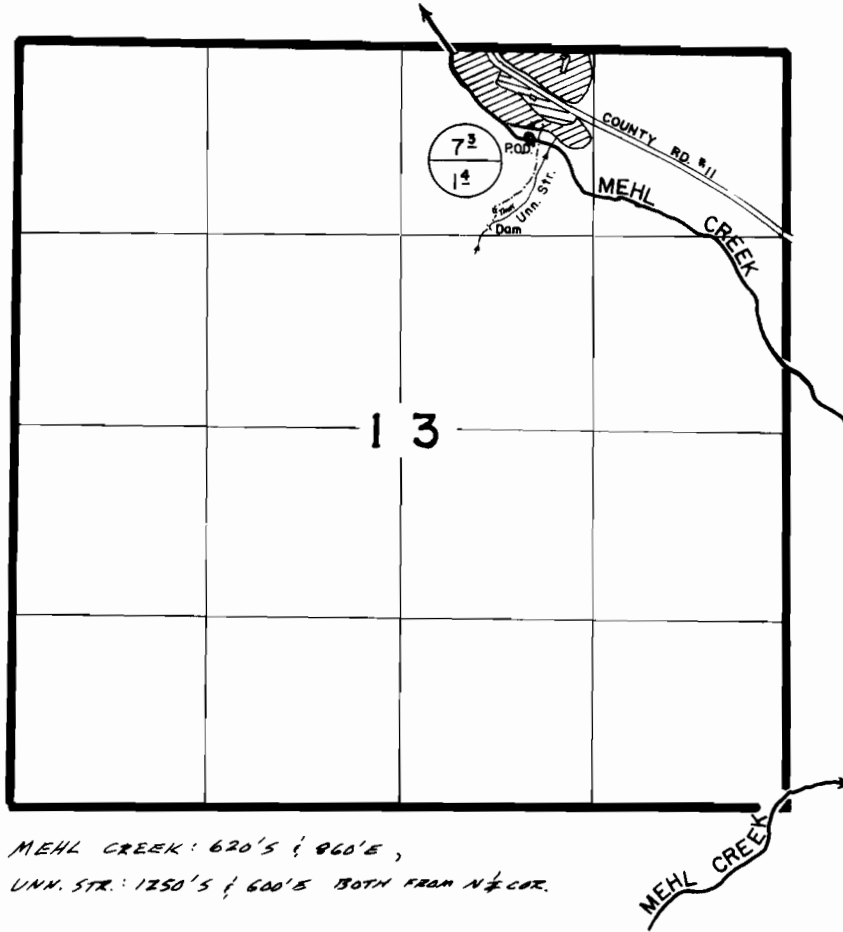

MEHL CREEK: 620'S & 860'E,
UNN. STR.: 1250'S & 600'E BOTH FROM N 1/4 COR.

Scale 1" = 1320'

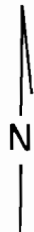

FINAL PROOF SURVEY UNDER

Application No. 60486 Permit No. 46290....
IN NAME OF

.....EDWARD J. COOLEY.....

Surveyed Sept. 18, 1990, by J.M.Schmaede.
May 17, 1994, B.S.James