


T. 5 S. R. 3 W. W.M.

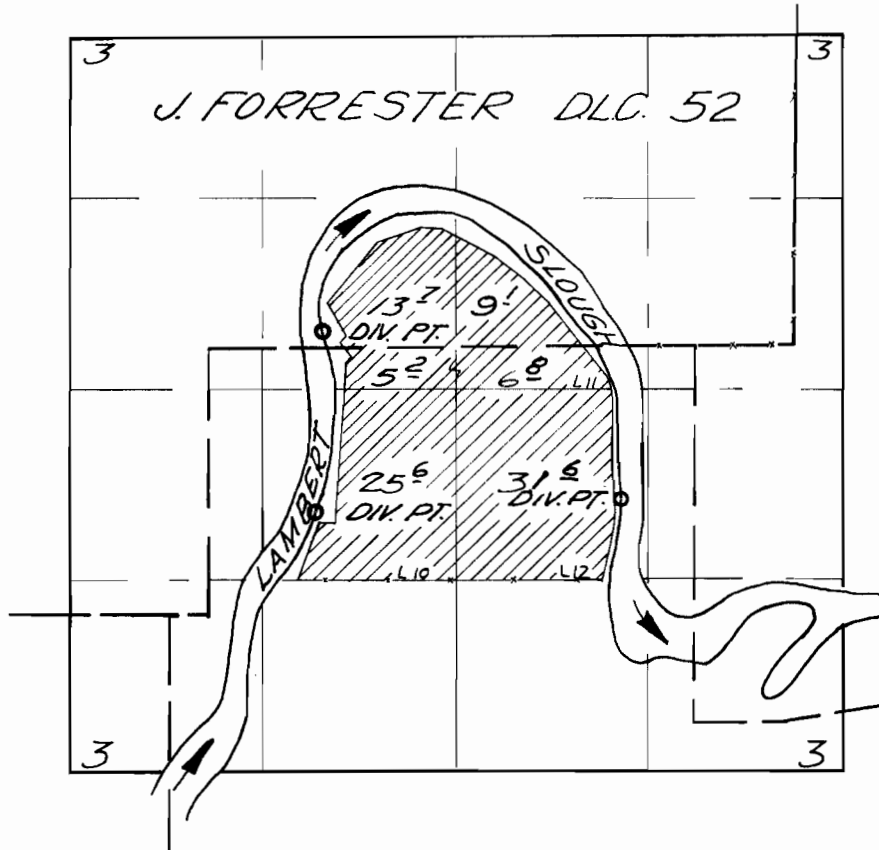

FINAL PROOF SURVEY
UNDER

Application No. 18111 Permit No. 13847
IN NAME OF

U.S. ALDERMAN

Surveyed May 1, 1941, by C. A. CUMMINGS