


# T.5S.R.3W.W.M.

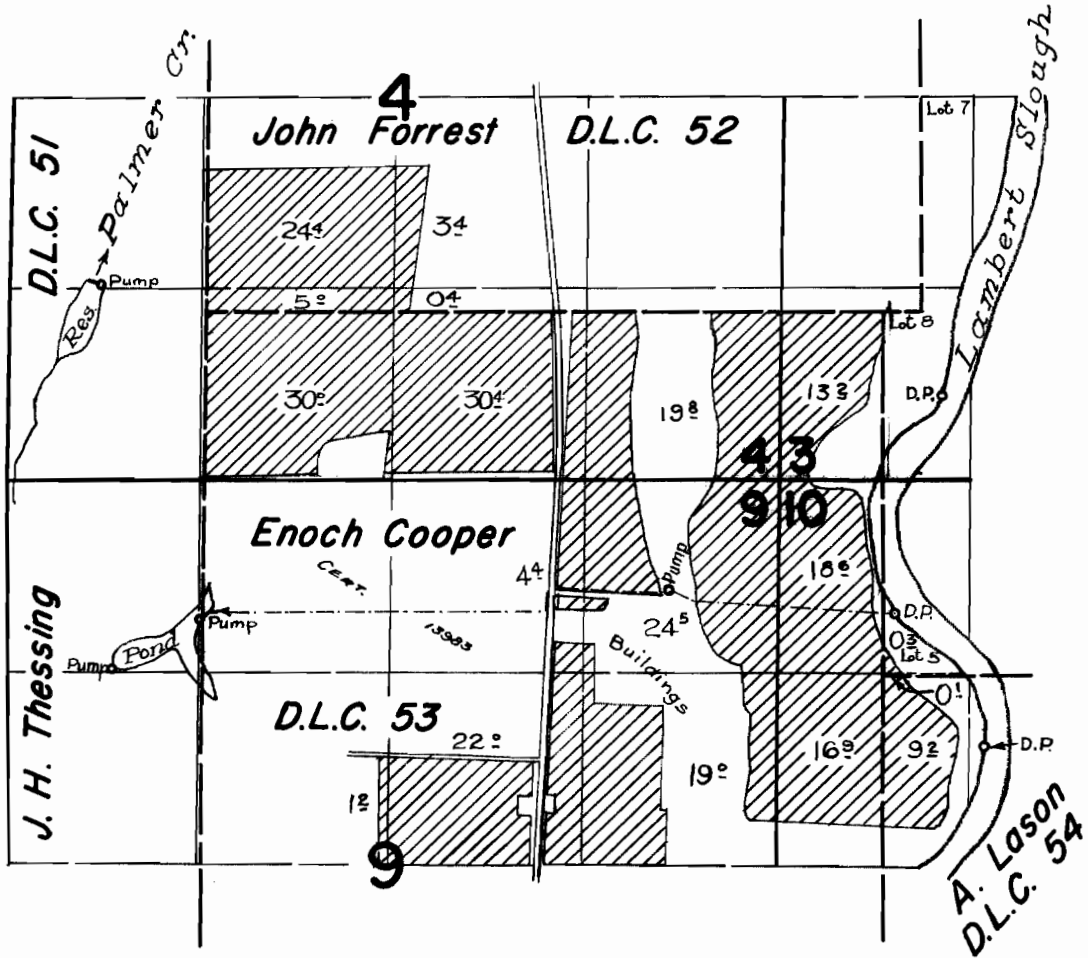

## FINAL PROOF SURVEY UNDER

Application No. **37183** Permit No. **27687**  
IN NAME OF

**U. S. ALDERMAN**

Surveyed August 30 1962, by

*[Signature]*