

Township 5 South, Range 3 West, W. M.

Portions of Sections 3, 4, 9 & 10

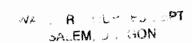

3 (;

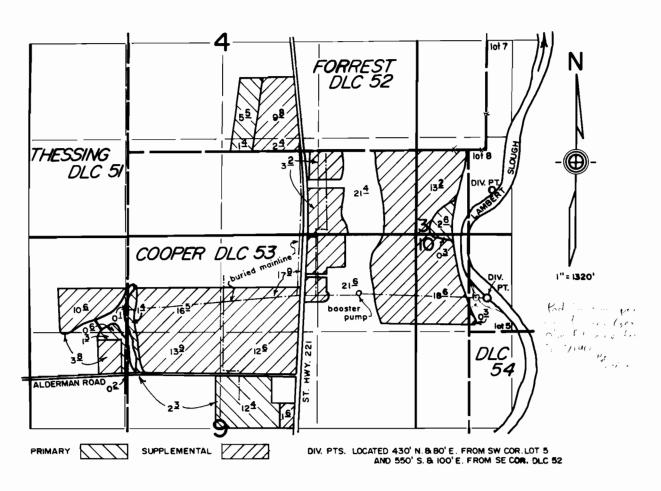

FINAL PROOF SURVEY
under
Appl. No. 73279, Per. No. 51937
in name of

Oct. 15, 1997



THIS MAP WAS PREPARED FOR THE PURPOSE OF IDENTIFYING THE LOCATION OF A WATER RIGHT ONLY AND IS NOT INTENDED TO PROVIDE LEGAL DIMENSIONS OR LOCATION OF PROPERTY OWNERSHIP LINES.