T. 2 N. R. 32 E. W.M.

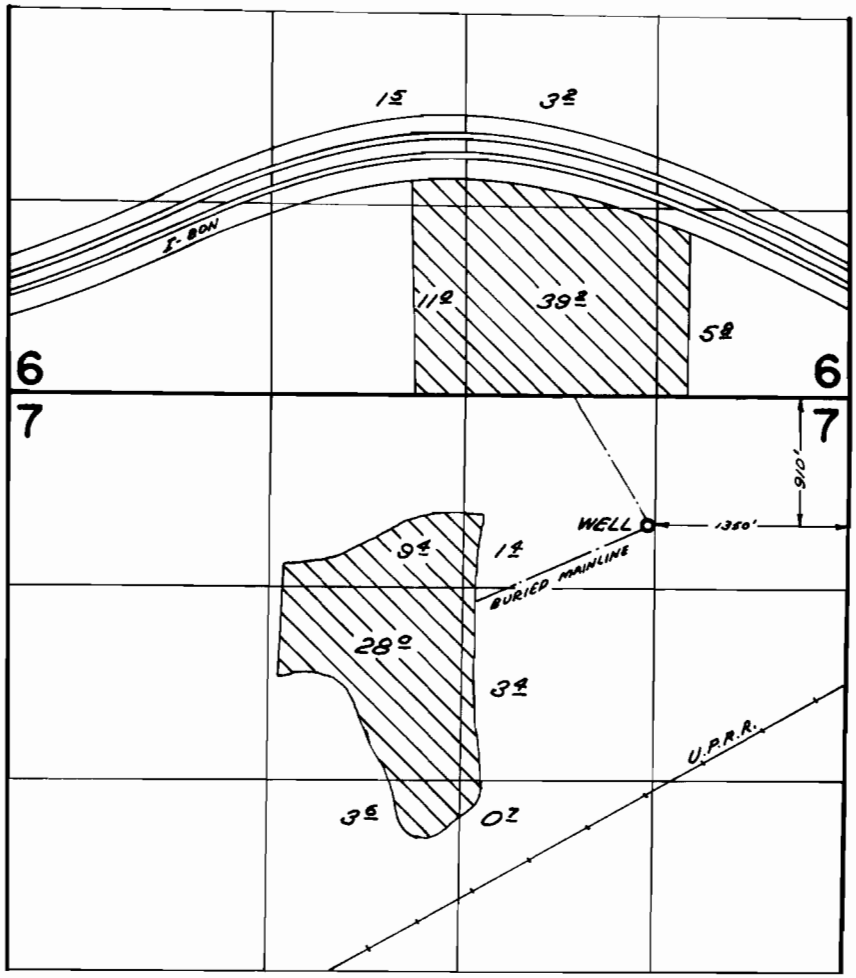

FINAL PROOF SURVEY
UNDER

Application No. G-3241 Permit No. G-3044
IN NAME OF

O. JAY BROGOITTI

Surveyed APR. 16 19 73, by D.M. NORBY

NE-2 MM-69 AM