


T. 2N. R. 32E. WM.

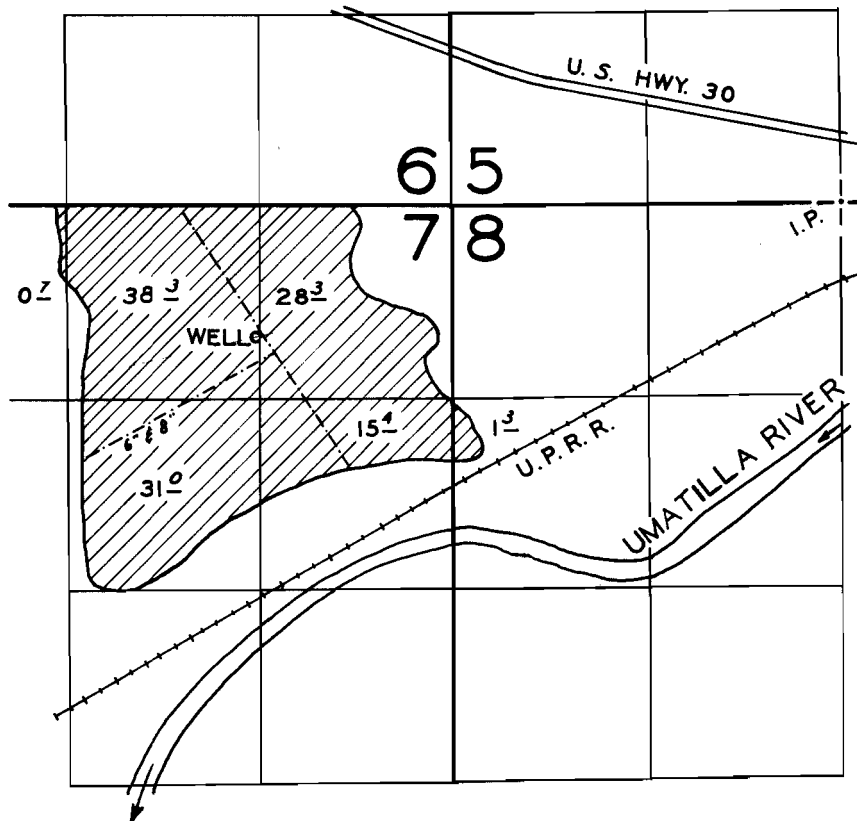

FINAL PROOF SURVEY
UNDER

Application No. G 532 Permit No. G 465
IN NAME OF

O. JAY BROGOITTI

Surveyed JULY 19 1960, by

[Handwritten signature]