


T.28S. R.14W. W.M.

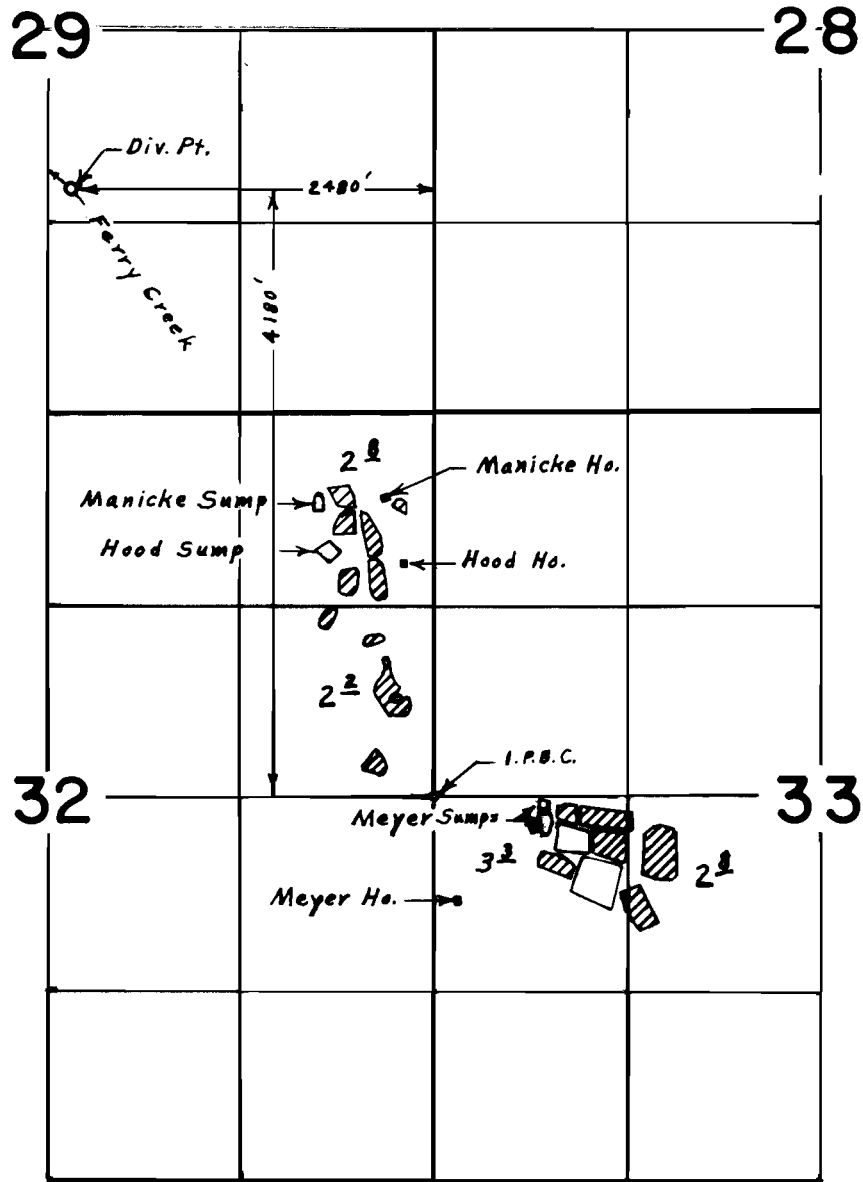

**FINAL PROOF SURVEY**  
UNDER

Application No. 42775 Permit No. 31857  
IN NAME OF

*Lowell Meyer et.al.*

Surveyed Aug. 27, 1976, by L. E. Gould.