


T.35 S. R.1 W.W.M.

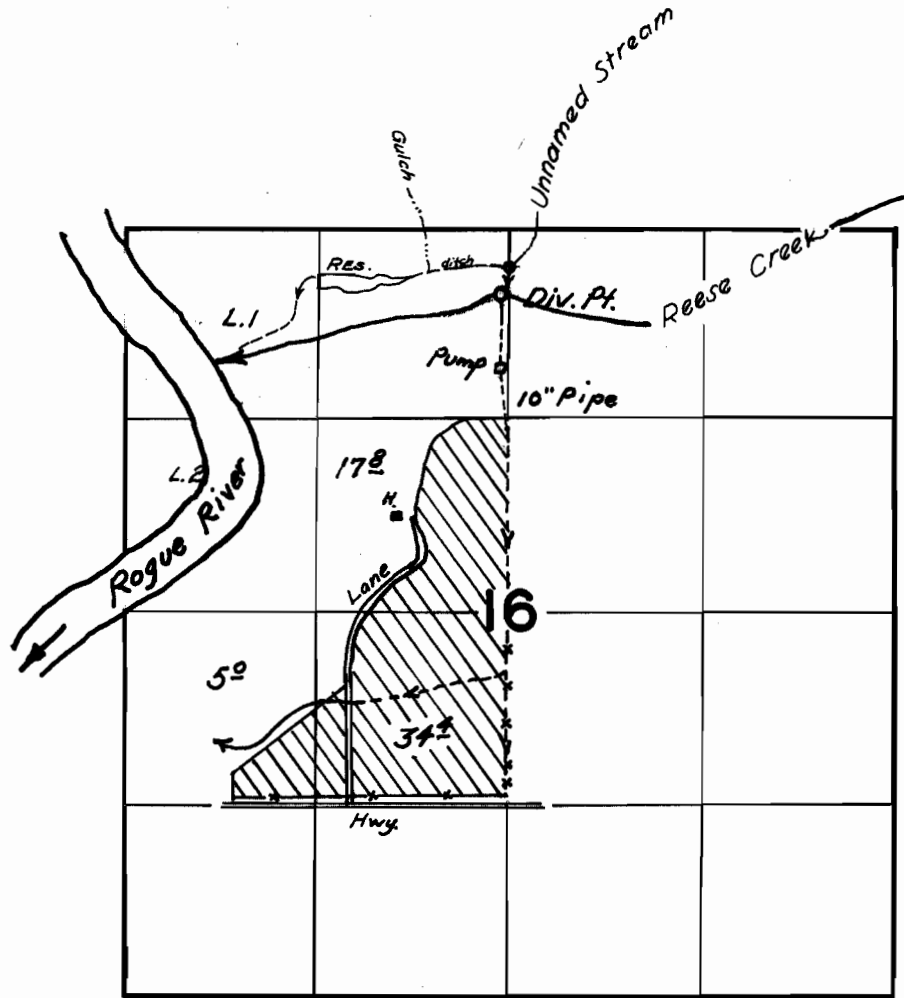

FINAL PROOF SURVEY
UNDER

Application No. 32808 Permit No. 26054
IN NAME OF

Margaret Grey Gizzi

Surveyed 13 April 1962, by Carl R. Baker