


RECEIVED

APR 17 1979

WATER RESOURCES DEPT
SALEM, OREGON

T. 22 S. R. 42 E. W.M.

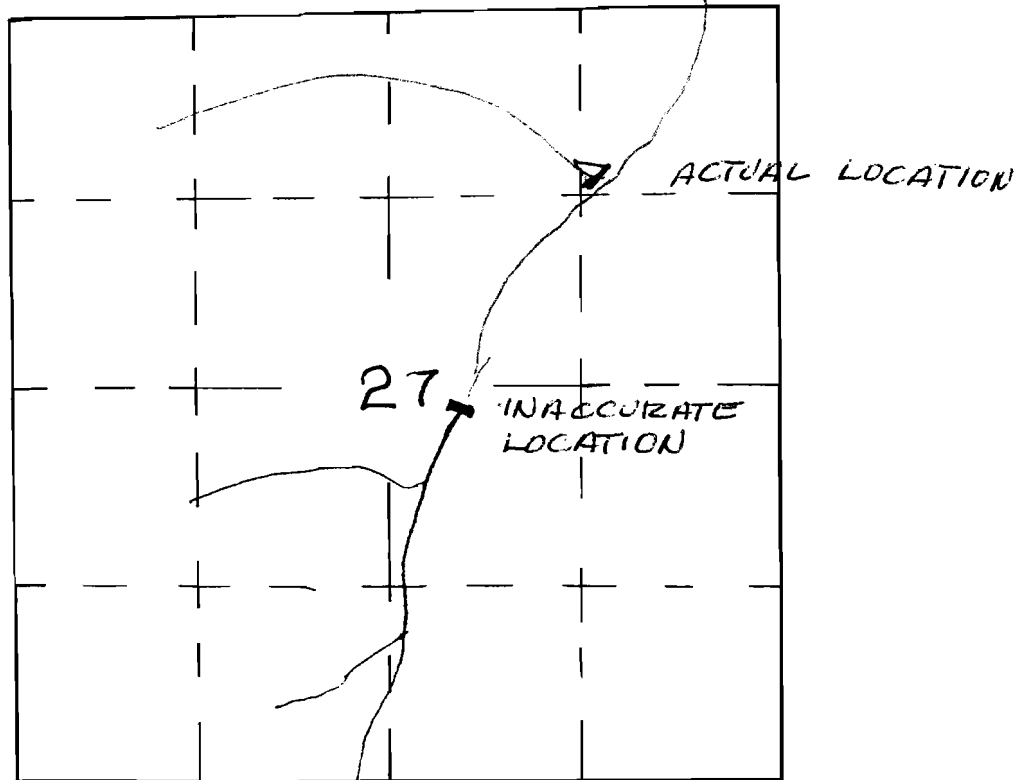

Application No. R59118

Permit No. R 8754

RECEIVED

APR 02 2002

WATER RESOURCES DEPT.
SALEM, OREGON

U. S. DEPARTMENT OF THE INTERIOR
BUREAU OF LAND MANAGEMENT

BELL MARE

DESIGNED _____

RECOMM. _____

DRAWN _____

RECOMM. _____

CHIEF, DIV. OF ENG.

CHECKED _____

APPROVED _____

SCALE _____

DATE _____

SHEET _____ OF _____

DRAWING NO. _____