

Fox Spring

RECEIVED
OCT 23 1983
WATER RESOURCES DEPT.
SALEM, OREGON

Application No. 67314
Permit No. 50493

Fox Prairie

FOREST BOUNDARY
ROAD FOREST BOUNDARY

UMATILLA CO
UNION CO

T1S
R35E



N

TOWNSHIP

15


RANGE

36 E

SECTION

35

W.M.

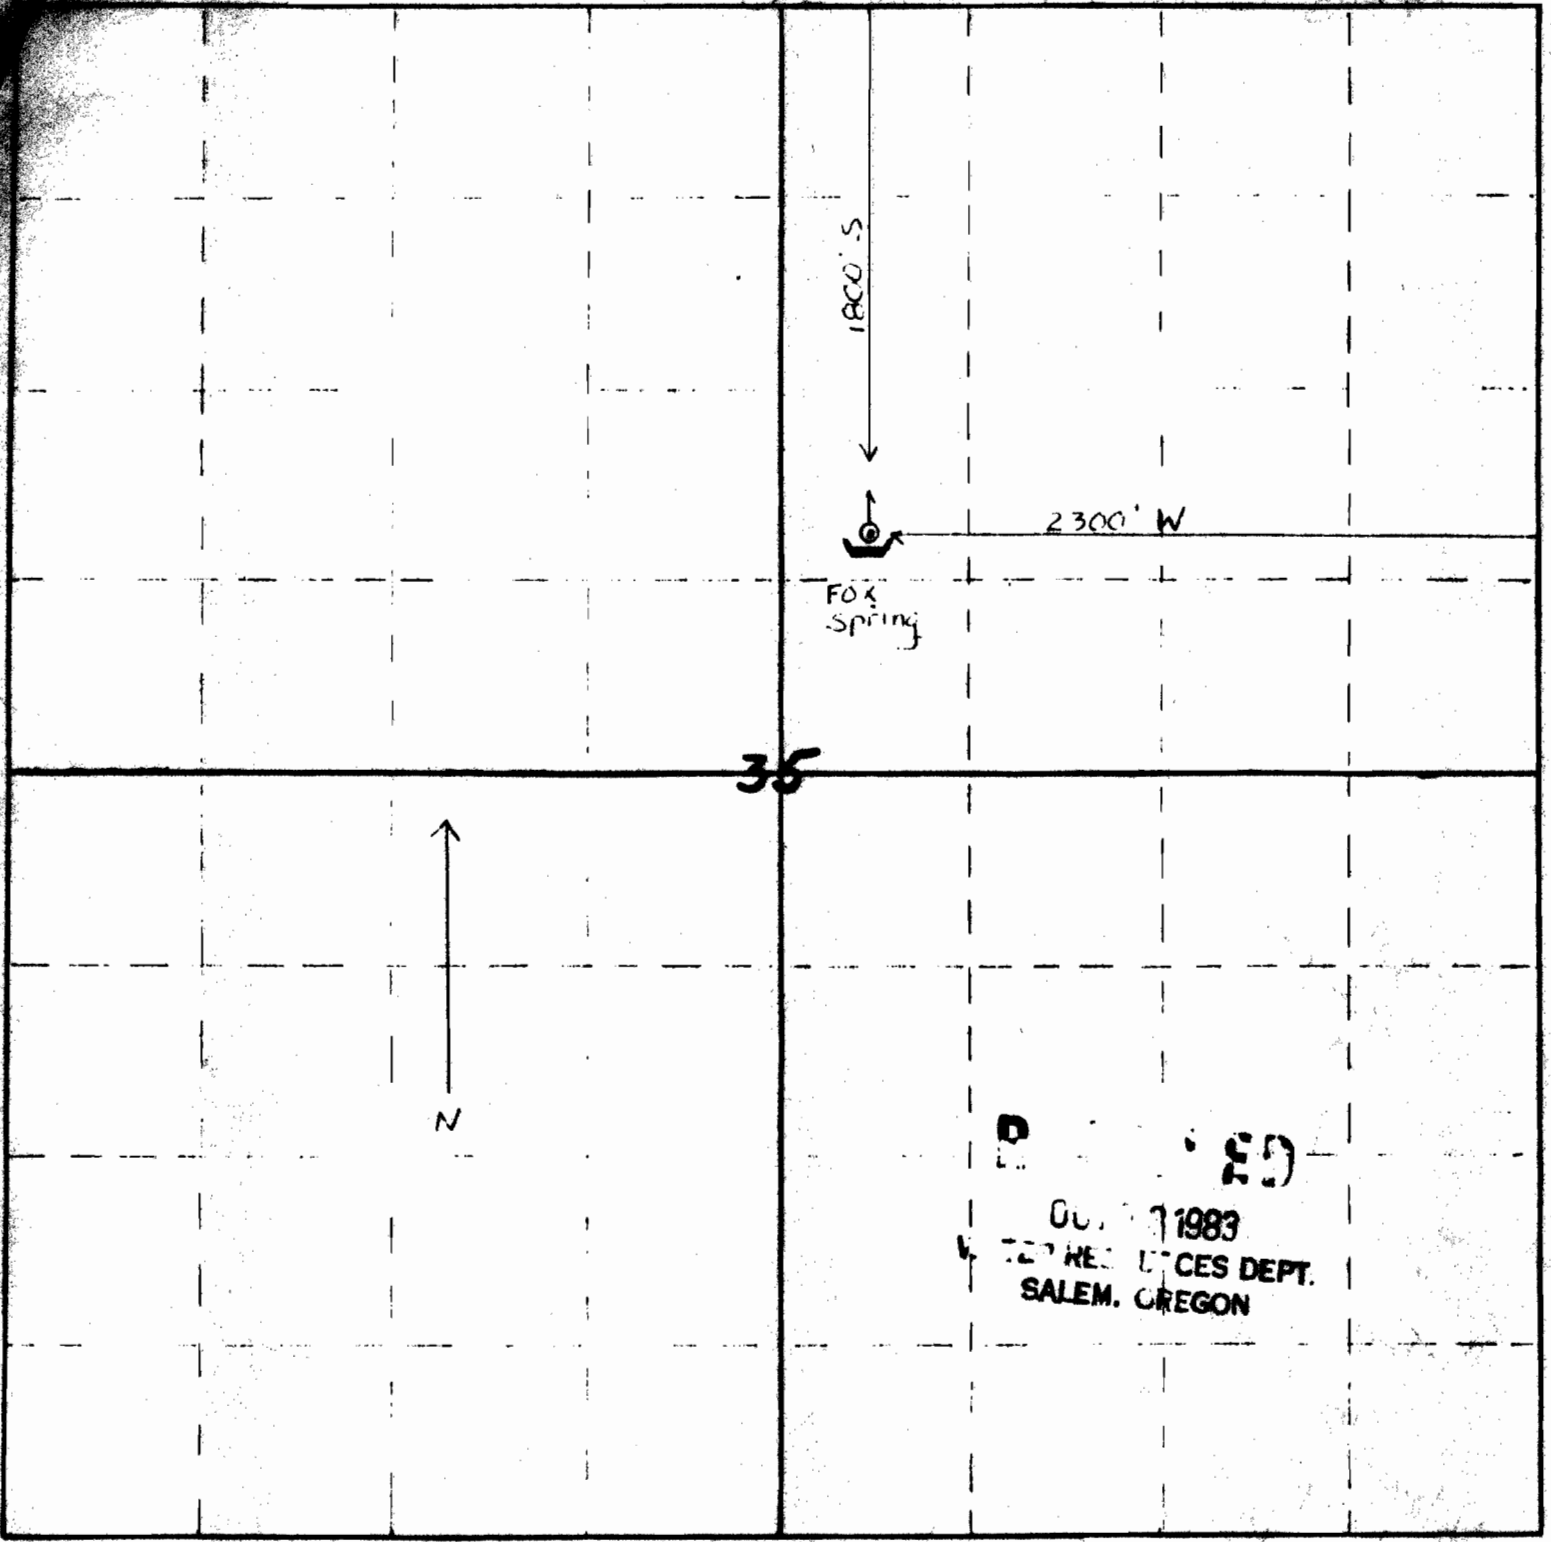

JUN 1983
 RESOURCES DEPT.
 SALEM, OREGON

NAME Fox Spring

COUNTY Umatilla

DISTRICT Walla Walla

ALLOTMENT Spring Mountain

Application No. 67314

Scale 8 inches = 1 Mile

Permit No. 50493

Umatilla, N.L.

