

5403
7949

S. McConen M.M. 4 Dec. 29

(Date of Registration)

T. 34 S. R. 19 E.

n


2340

5403

Application to

Patent No.

March 24
Sec.
30

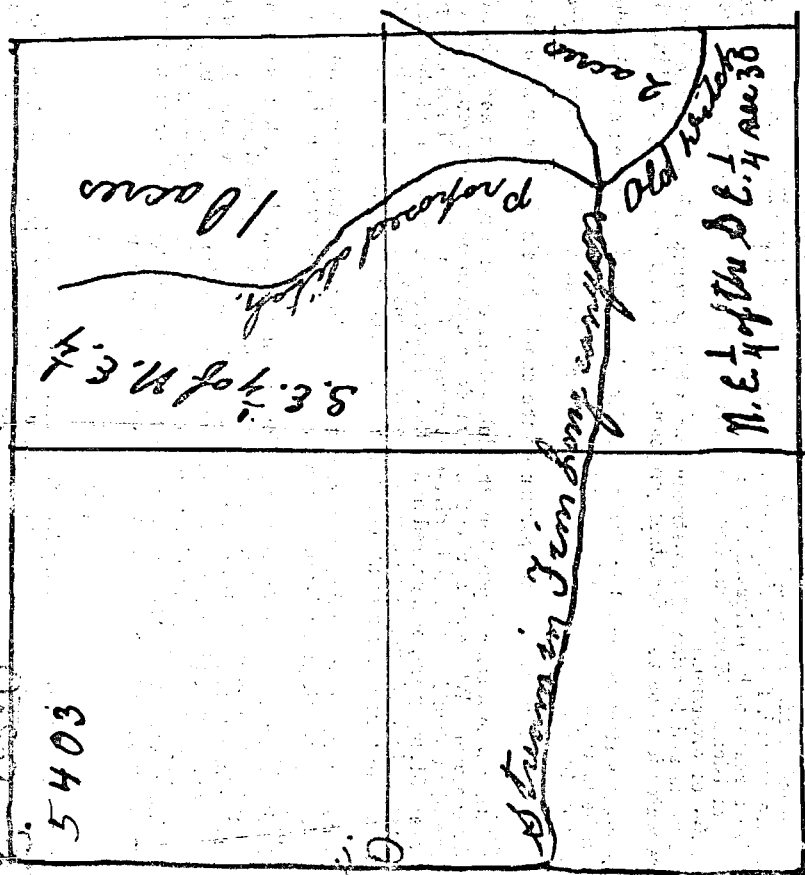

11