

APPLICATION MAP FOR PERMIT TO CONSTRUCT A RESERVOIR


NE1/4 SE1/4 SEC 12 T 33S R 43E W.M.

U.S.G.S. QUAD - SKULL CREEK, OREG. - 7 1/2'

RECEIVED

MAY - 9 1994


WATER RESOURCES DEPT.
SALEM, OREGON

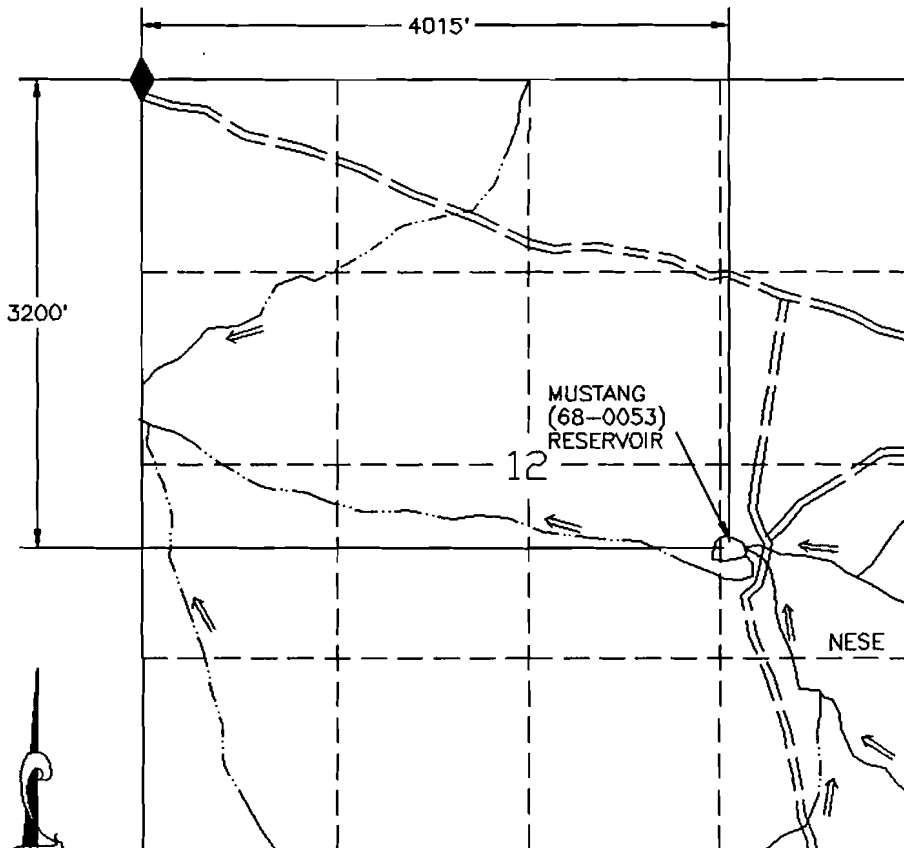

LEGEND

- RESERVOIR
- ROAD
- CHANNEL
- FD SEC COR


MUSTANG (68-0053) RESERVOIR

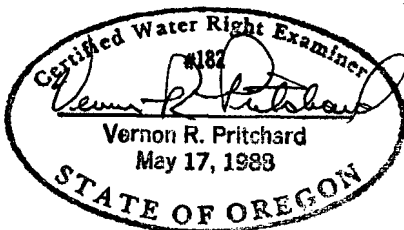

UNITED STATES DEPARTMENT OF THE INTERIOR
BUREAU OF LAND MANAGEMENT
DIVISION OF OPERATIONS VALE DISTRICT

MUSTANG (68-0053)
RESERVOIR

DESIGNED	<i>Vernon R. Pritchard</i>	
REVIEWED	<i>George H. House</i>	
APPROVED	CHIEF, BRANCH OF ENGINEERING	
DRAWN:	CG	SCALE: 1"=1320'
DATE:	09/23/93	SHEET 1 OF 1
DRAWING NO. OR-03-9172.45-425		

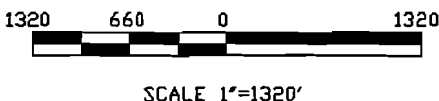

THIS MAP IS FOR THE PURPOSE OF LOCATING
A WATER RIGHT AND IS NOT INTENDED TO
PROVIDE LEGAL DIMENSIONS FOR LOCATION
OF PROPERTY BOUNDARIES.

ACAD RELEASE 11/04
DWG FILEMUSTANGA.DWG

CERTIFICATE NO.

748??
03152

APPLICATION MAP FOR PERMIT TO CONSTRUCT A RESERVOIR


SE 1/4 NW 1/4 SEC 28 T 38S R 44E W.M.

U.S.G.S. QUAD - GRASSHOPPER FLAT SOUTH - 7 1/2'

RECEIVED

MAY - 9 1994


WATER RESOURCES DEPT.
SALEM, OREGON

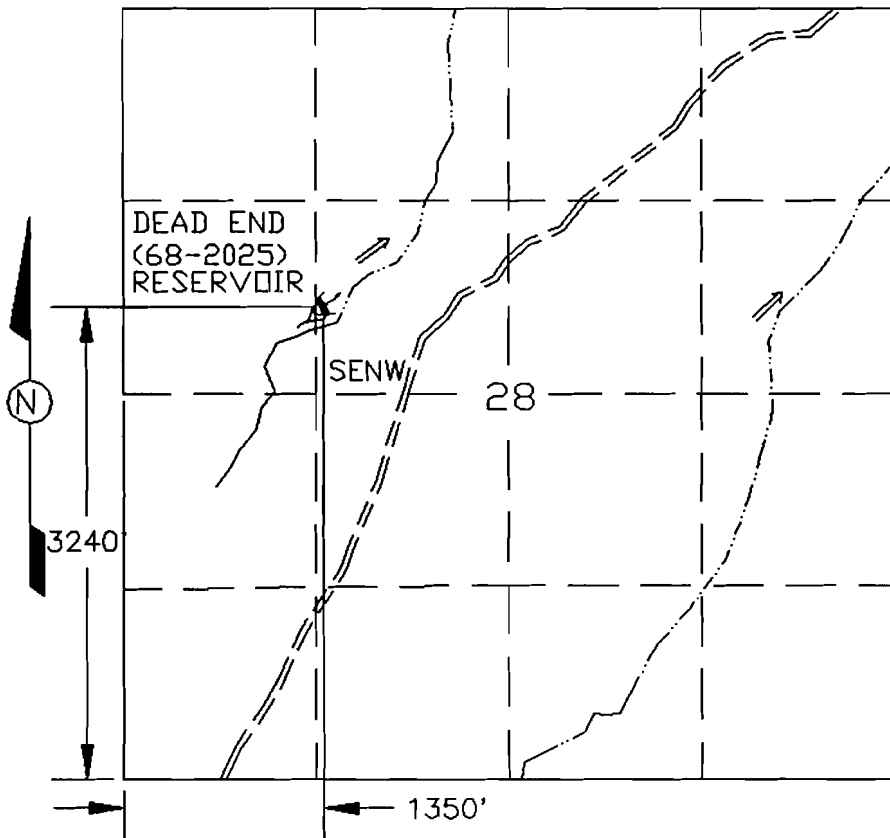

LEGEND

-  RESERVOIR
-  ROAD
-  CHANNEL

1320 660 0 1320


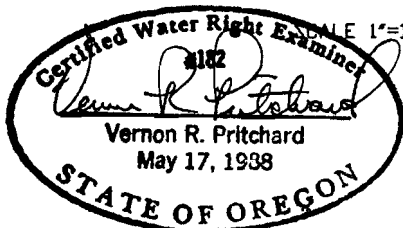


THIS MAP IS FOR THE PURPOSE OF LOCATING
A WATER RIGHT AND IS NOT INTENDED TO
PROVIDE LEGAL DIMENSIONS FOR LOCATION
OF PROPERTY BOUNDARIES.



UNITED STATES DEPARTMENT OF THE INTERIOR
BUREAU OF LAND MANAGEMENT
DIVISION OF OPERATIONS VALE DISTRICT

DEAD END (68-2025) RESERVOIR

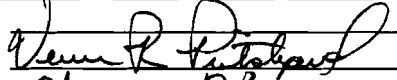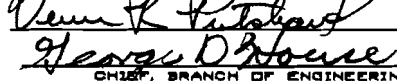DESIGNED 
REVIEWED 
APPROVED 
CHIEF, BRANCH OF ENGINEERING

DRAWN: CG SCALE: 1"=1320'
DATE: 01/19/93 SHEET 1 OF 1
DRAWING NO. OR-03-9172.45-183

ACAD RELEASE 11/DCA
DWG FILE: DEADENDA.DWG

CERTIFICATE NO. ~~77152~~
74877

APPLICATION MAP FOR PERMIT TO CONSTRUCT A RESERVOIR

SW1/4SW1/4 SEC 23 T 33S R 43E W.M.

U.S.G.S. QUAD - INDIAN FORT, OREG. - 7 1/2'



RECEIVED

MAY - 9 1994


WATER RESOURCES DEPT.
SALEM, OREGON

LEGEND

- RESERVOIR
- TRAIL
- - - CHANNEL
- ◆ FD SEC COR

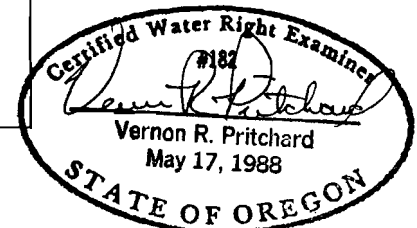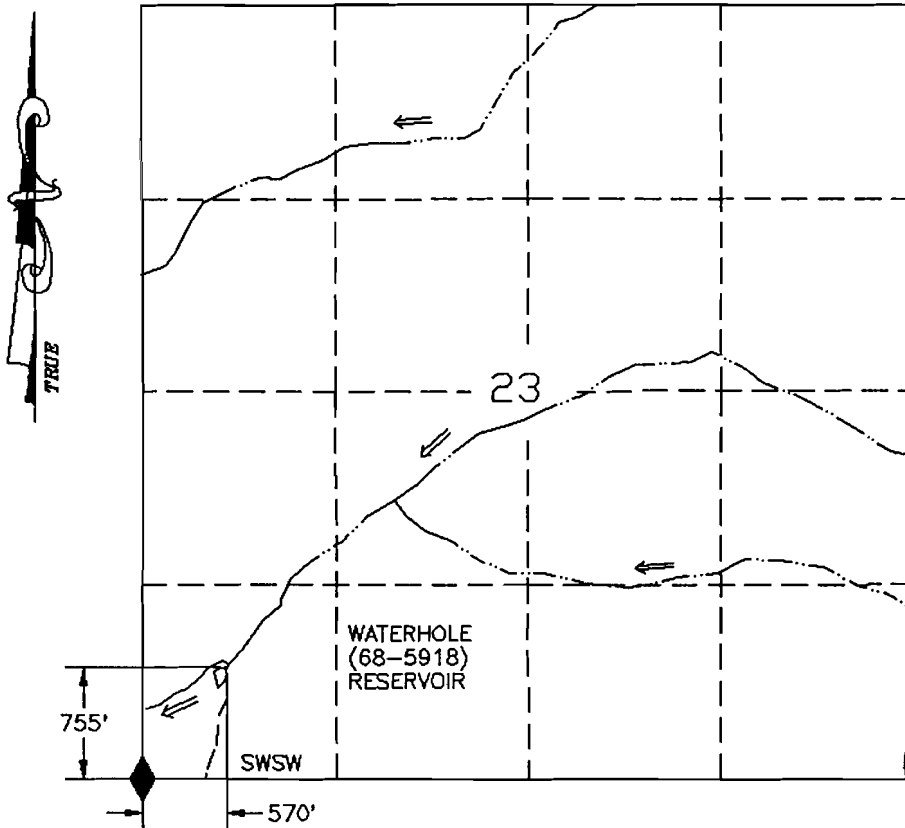

WATERHOLE (68-5918) RESERVOIR

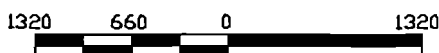

SCALE 1"=1320'

THIS MAP IS FOR THE PURPOSE OF LOCATING
A WATER RIGHT AND IS NOT INTENDED TO
PROVIDE LEGAL DIMENSIONS FOR LOCATION
OF PROPERTY BOUNDARIES.



ACAD RELEASE 11/DCA
DWG FILE: WATERHOL.DWG

UNITED STATES DEPARTMENT OF THE INTERIOR BUREAU OF LAND MANAGEMENT DIVISION OF OPERATIONS VALE DISTRICT	
WATERHOLE (68-5918) RESERVOIR	
DESIGNED	<i>Vernon R. Pritchard</i>
REVIEWED	<i>George D. House</i>
APPROVED	<i>George D. House</i> CHIEF, BRANCH OF ENGINEERING
DRAWN: CG	SCALE: 1"=1320'
DRAWING NO. OR-03-9172.45-488	

CERTIFICATE NO.

77152

74877

APPLICATION MAP FOR PERMIT TO CONSTRUCT A RESERVOIR


GOV'T. LOT 4 SEC 3 T 34S R 43E W.M.

U.S.G.S. QUAD - INDIAN FORT, OREG. - 7 1/2'

RECEIVED

MAY - 9 1994


WATER RESOURCES DEPT.
SALEM, OREGON

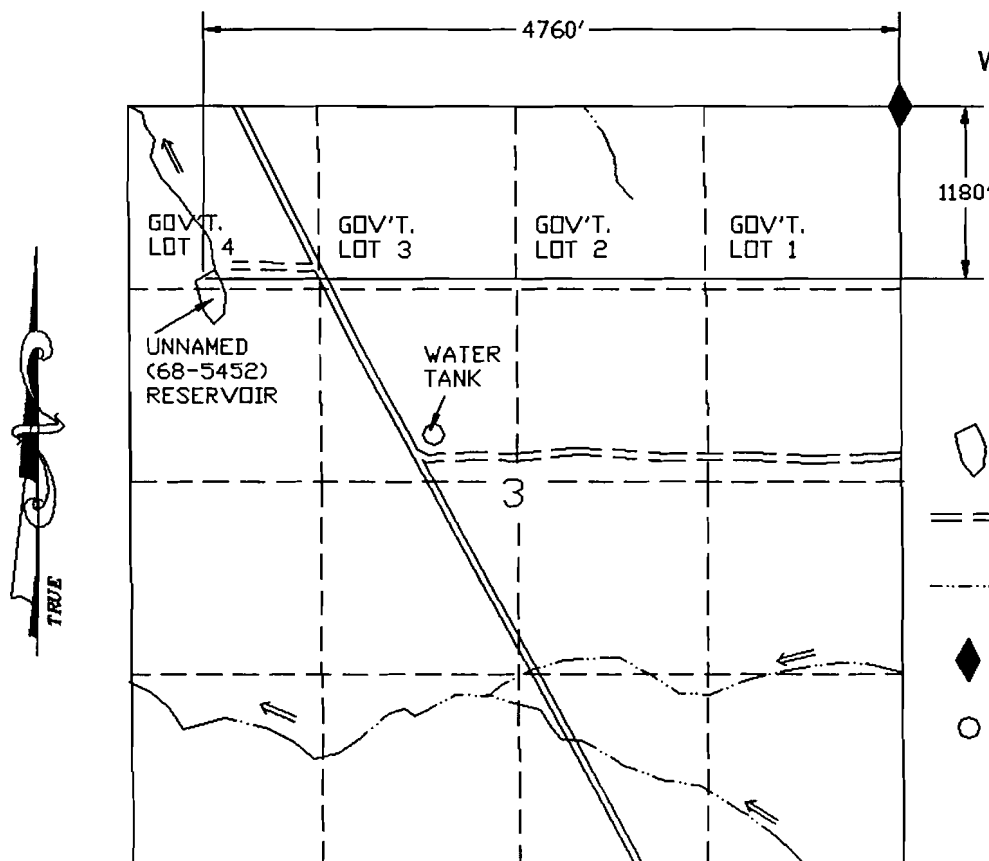

LEGEND

- RESERVOIR
- ROAD
- CHANNEL
- FD SEC COR
- WATER TANK

UNNAMED (68-5452) RESERVOIR

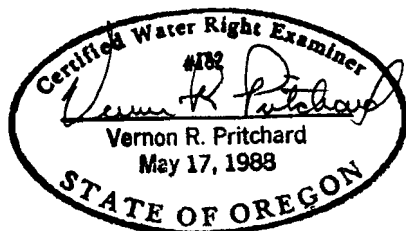

1320 660 0 1320

SCALE 1"=1320'

THIS MAP IS FOR THE PURPOSE OF LOCATING
A WATER RIGHT AND IS NOT INTENDED TO
PROVIDE LEGAL DIMENSIONS FOR LOCATION
OF PROPERTY BOUNDARIES.



UNITED STATES DEPARTMENT OF THE INTERIOR
BUREAU OF LAND MANAGEMENT
DIVISION OF OPERATIONS VALE DISTRICT

UNNAMED(68-5452)
RESERVOIR

DESIGNED
REVIEWED
APPROVED

DRAWN: CG SCALE: 1"=1320'
DATE: 09/26/93 SHEET 1 OF 1

DRAWING NO. OR-03-9172.45-452

ACAD RELEASE 11/0CA
DWG FILE: T34SR43E

RECEIVED

74877
f3152

APPLICATION MAP FOR PERMIT TO CONSTRUCT A RESERVOIR


SE1/4 SW1/4 SEC 30 T 31S R 38E W.M.

U.S.G.S QUAD - GRAND CANYON, OREG. - 7 1/2'

RECEIVED

MAY - 9 1994



WATER RESOURCES DEPT.
SALEM, OREGON

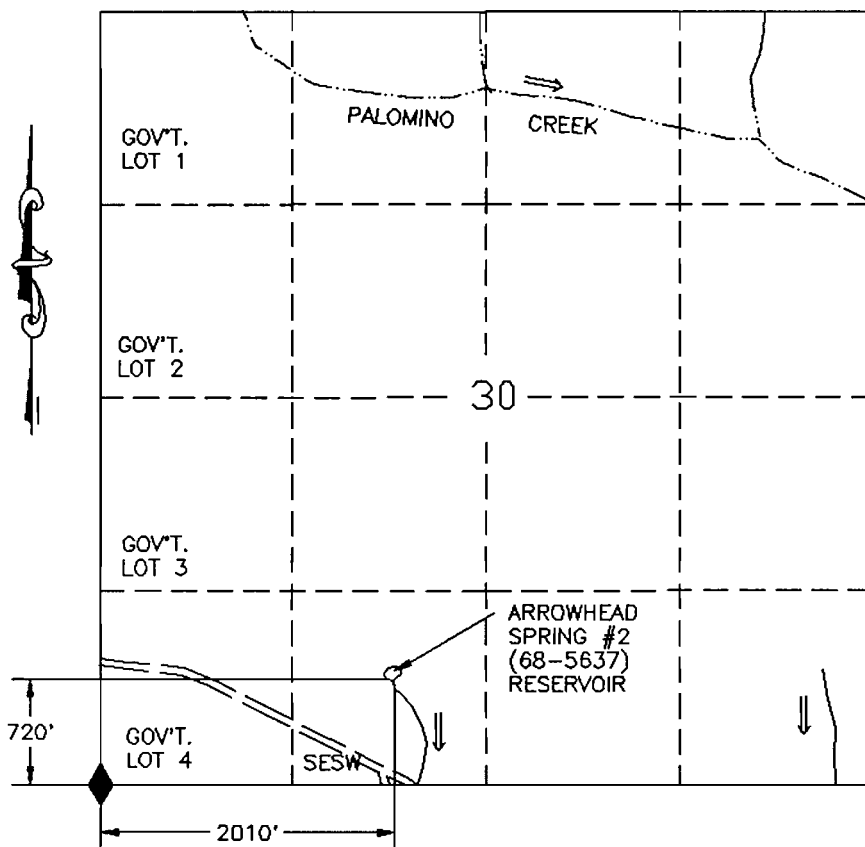

LEGEND

- RESERVOIR
- == ROAD
- CHANNEL
- ◆ FD SEC COR

ARROWHEAD SPRING #2 (68-5637) RESERVOIR

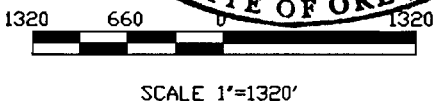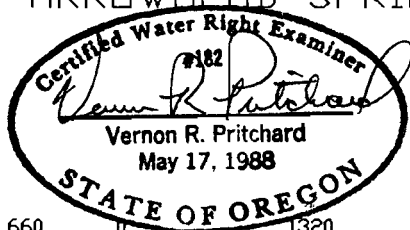

THIS MAP IS FOR THE PURPOSE OF LOCATING
A WATER RIGHT AND IS NOT INTENDED TO
PROVIDE LEGAL DIMENSIONS FOR LOCATION
OF PROPERTY BOUNDARIES.



UNITED STATES DEPARTMENT OF THE INTERIOR BUREAU OF LAND MANAGEMENT DIVISION OF OPERATIONS VALE DISTRICT	
ARROWHEAD SPRING #2 (68-5637) RESERVOIR	
DESIGNED	<i>Vernon R. Pritchard</i>
REVIEWED	<i>George D. House</i>
APPROVED	CHIEF, BRANCH OF ENGINEERING
DRAWN: CG	SCALE: 1"=1320'
DATE: 08/09/93	SHEET 1 OF 1
DRAWING NO. OR-03-9172.45-387	

ACAD RELEASE 11/DCA
DWG FILE: ARROW2AP.DWG

"CERTIFICATE NO.

74822
67152