


T.26S. R.6W. W.M.

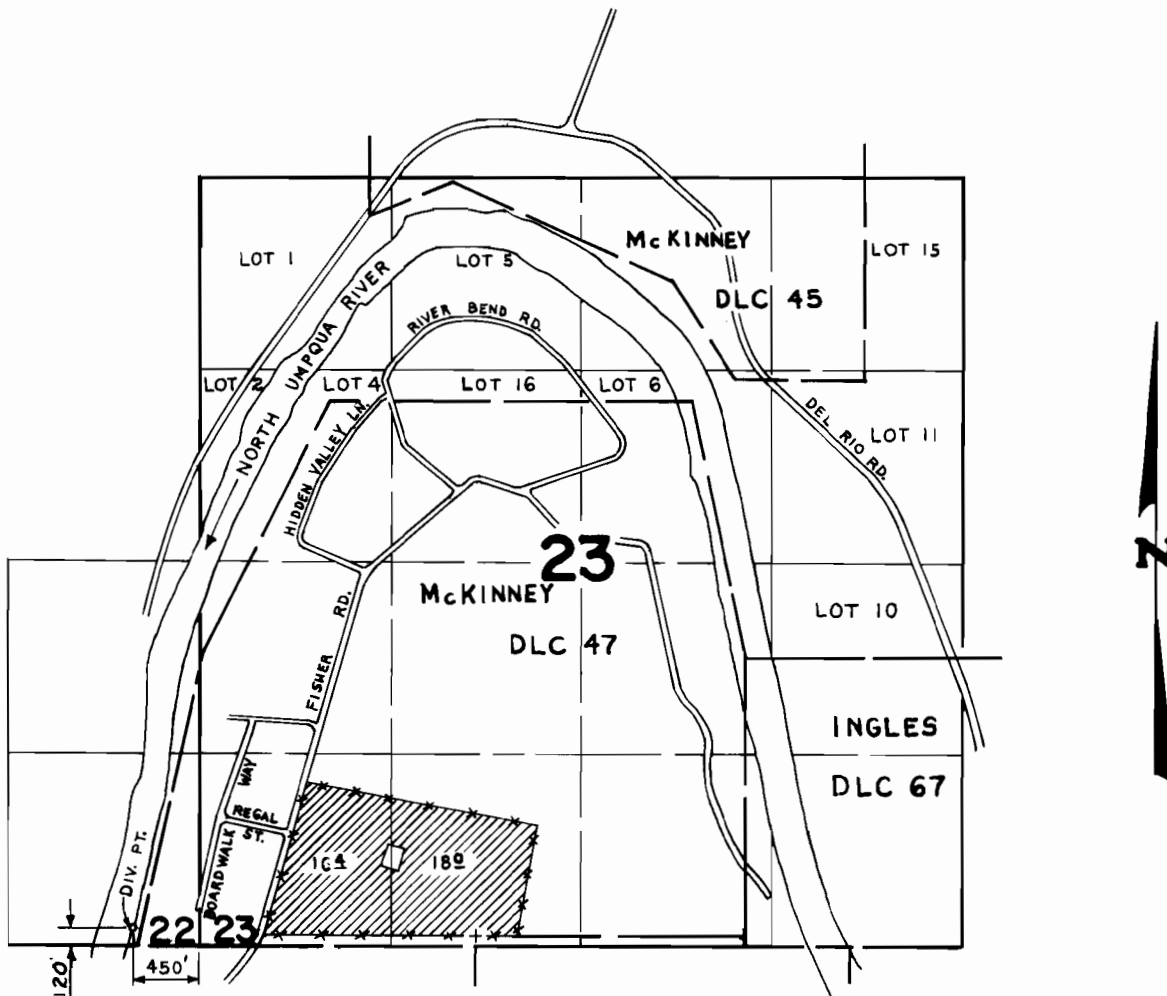

SCALE: 4" = 1 mile

FINAL PROOF SURVEY UNDER

Application No. 63422.. Permit No. 46773.....
IN NAME OF

JOE G. MACHADO JR......

Surveyed DEC. 9. 1983, by L. CASHION.....