


G-5850
54688
T5575
T8889
79516

T.25S. R.14E. W.M.

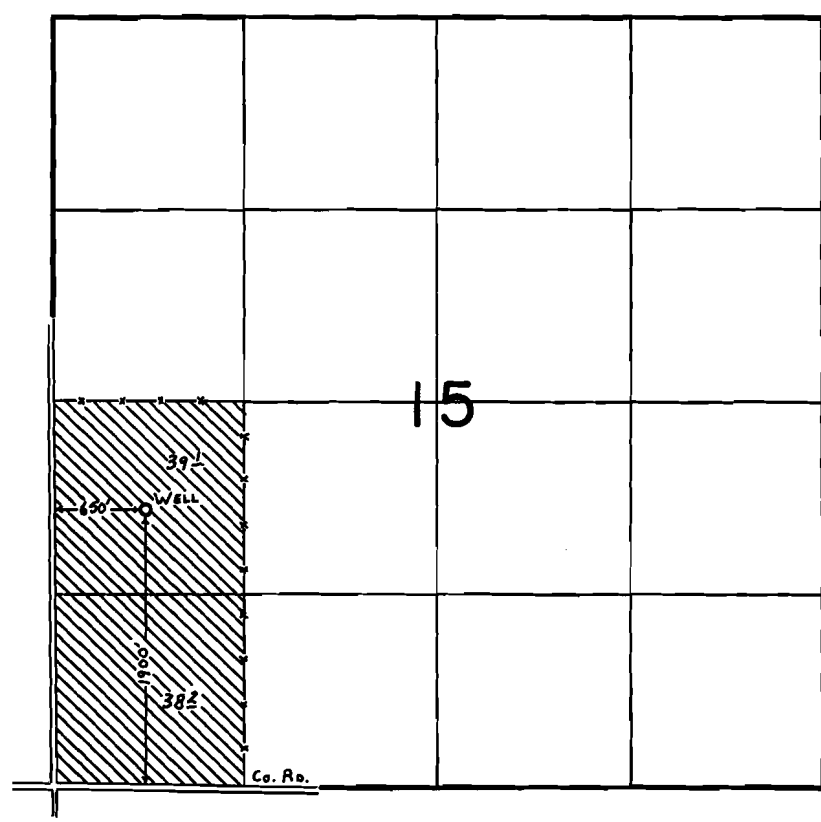

FINAL PROOF SURVEY
UNDER

Application No. G-6167 Permit No. G-5850
IN NAME OF

Robert Carl Reed

Surveyed Aug. 30, 1979, by C. L. HUGHES