


T.25S. R.14E., W.M.

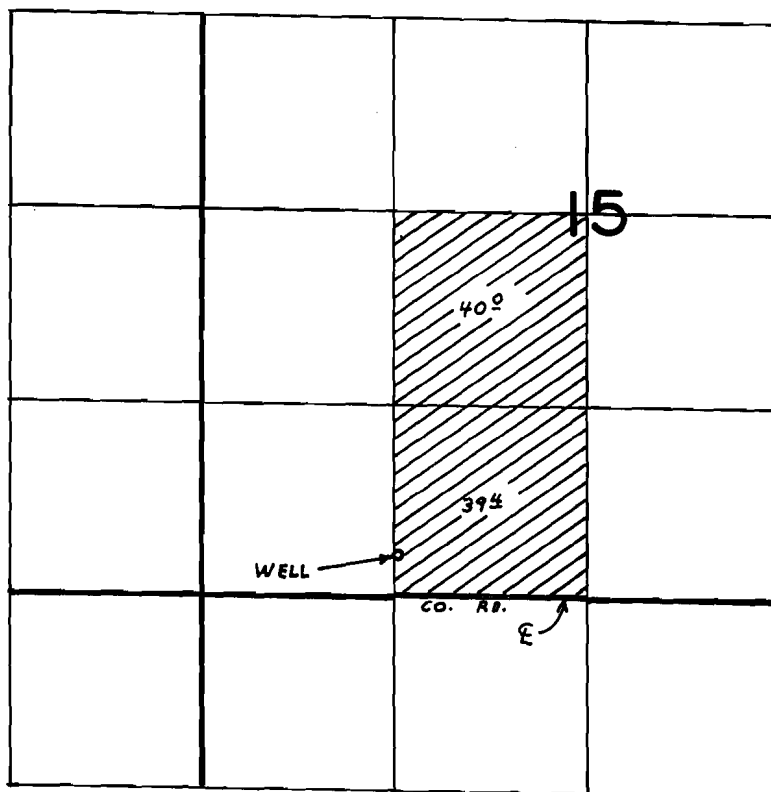

WELL LOC. 280' N. & 1300' W. FROM S 1/4 COR. SEC. 15


FINAL PROOF SURVEY
UNDERApplication No. G-7214... Permit No. G-6637...
IN NAME OF

.....ROBERT CARL REED.....

Surveyed JUL 16, 1977, by D.M. NORBY.....

48464
G 6637

T.25S. R.14E., W.M.

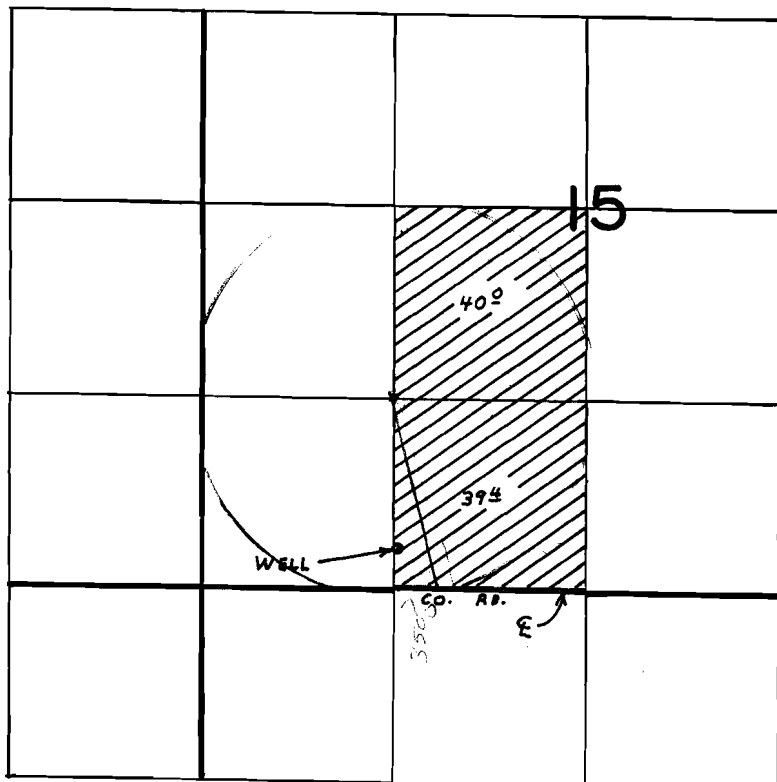

WELL LOC. 280' N. & 1300' W. FROM $5\frac{1}{4}$ COR. SEC. 15

FINAL PROOF SURVEY
UNDER



Application No. G-7214... Permit No. G-6637...
IN NAME OF

.....ROBERT CARL REED.....

Surveyed JUL 16, 1977, by D.M. NORBY.....

T 5575
T 5576
G-6637
Cert. 55093
Cert. 53002

T. 25S., R. 14E., W.M.

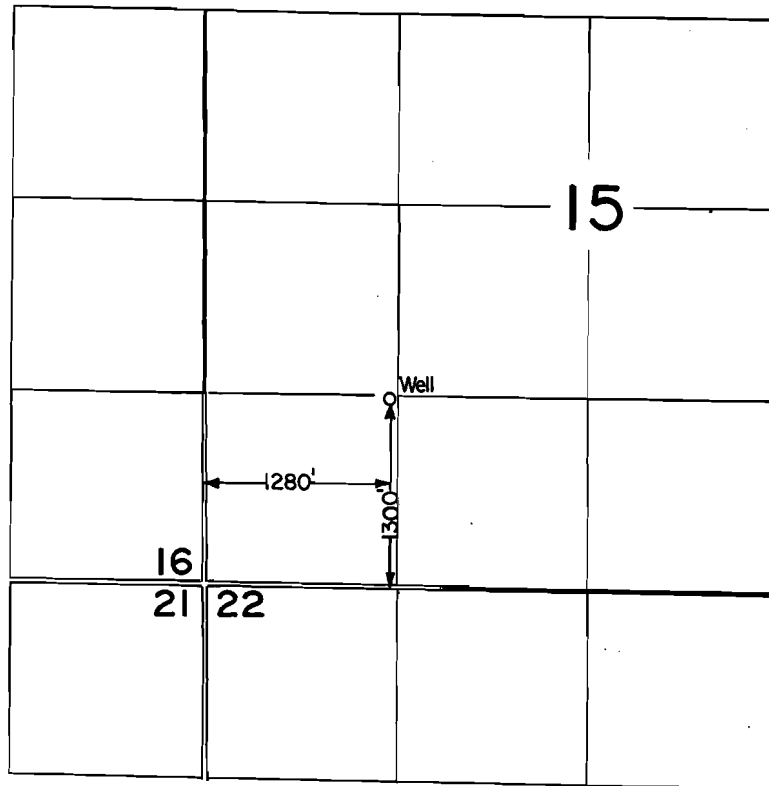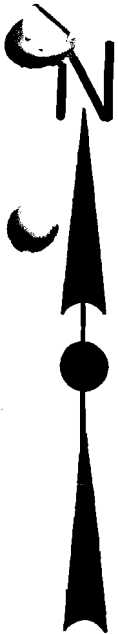

Scale: 1" = 1320'

FINAL PROOF SURVEY
UNDER

Transfers 5575 & 5576

Application No. Permit No.

IN NAME OF

ROBERT CARL REED

Surveyed Sept. 18, 1985, by T. Warren.....