

G-5621


46678

T9031

79519

T9031

T.35&36S.R.24E.W.M.

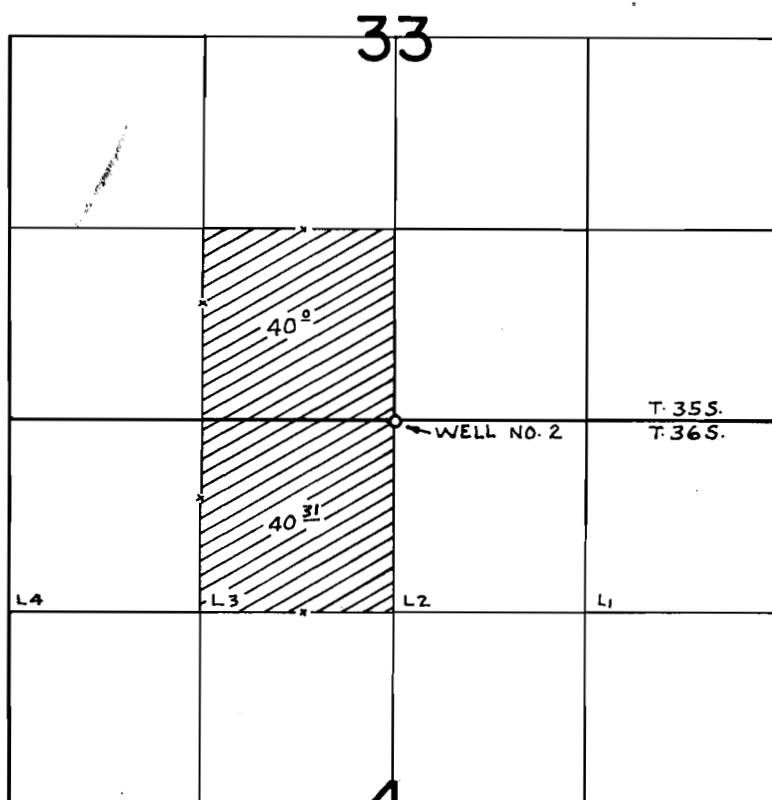

WELL LOC: 11' S. & 13' E. FROM N. 1/4 COR. SEC. 4

FINAL PROOF SURVEY
UNDER

Application No. G-5709 Permit No. G-5621
IN NAME OF

W. C. Laird

Surveyed OCT. 22, 1976, by R. MUCKEN