


6283
7952

MAP

To accompany the application of Wm Schuster.
Made from notes furnished by applicant.

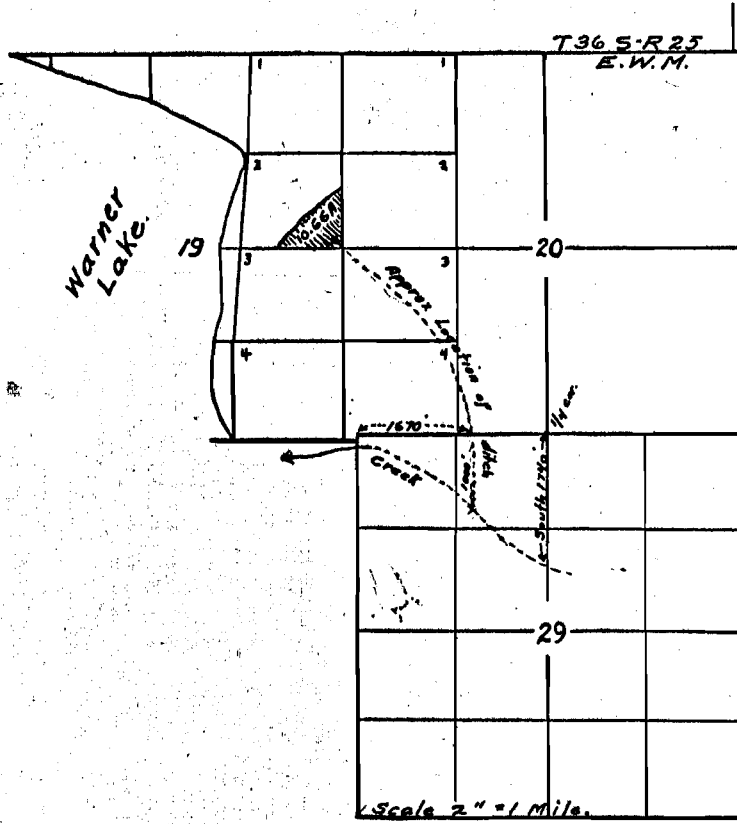

9510

Application No. 9510
Permit No. 6283

STATE ENGINEER
RECEIVED

MAY 12 1924

SALEM, OREGON