


G 7106
51142
T9031

79520
T9031

T35. & 36S. R24E. W.M.

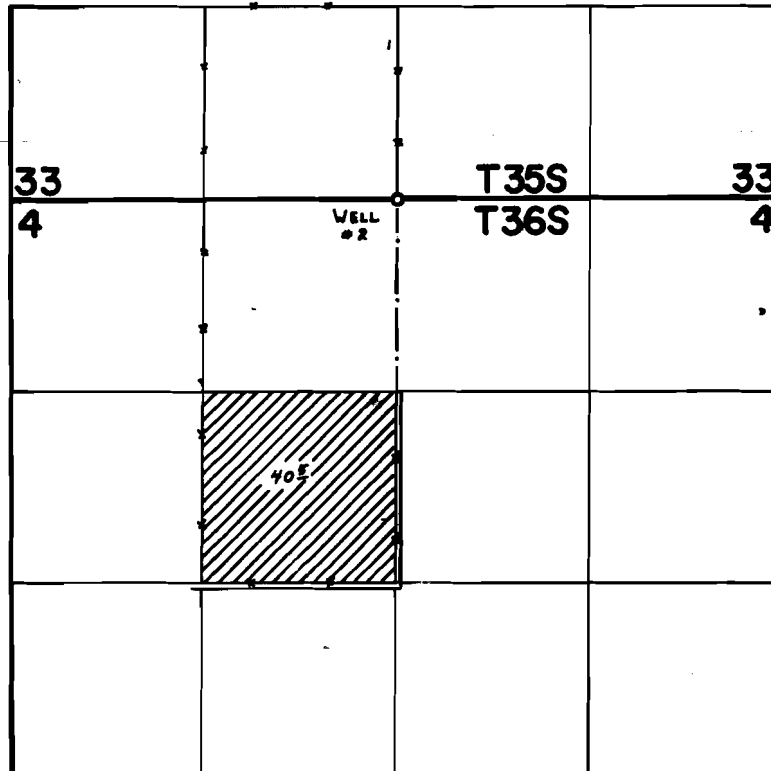

WELL LOC: 11'S & 13'E. fr. N. 1/4 COR. SEC. 4.

**FINAL PROOF SURVEY
UNDER**

Application No. G-7669 Permit No. G-7106
IN NAME OF

W. C. LAIRD

Surveyed JUNE 27 1978, by C. L. HUGHES