
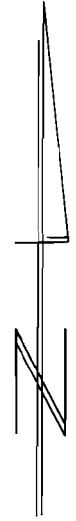


# T 6 S, R 4 W, WM

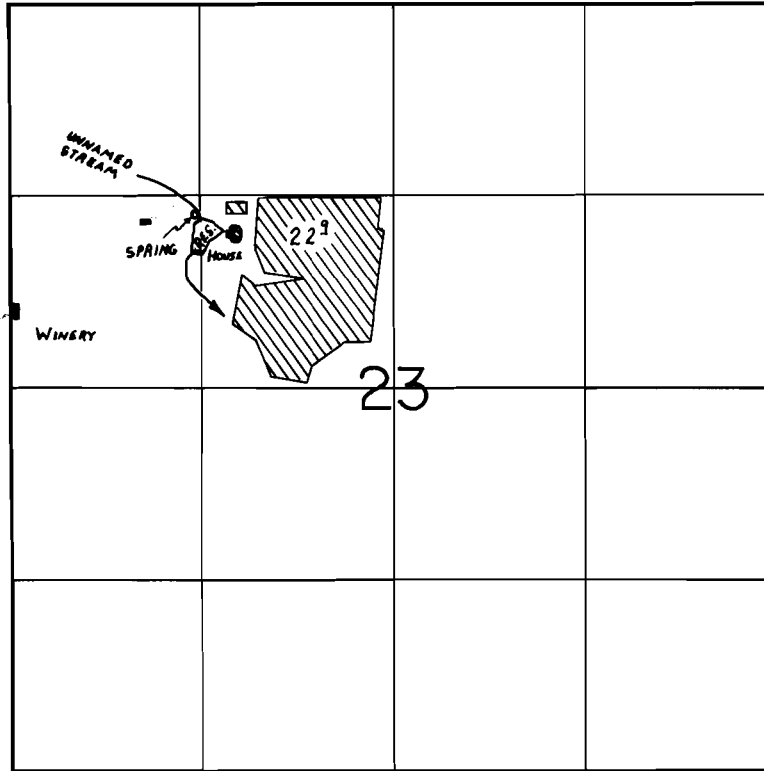

SCALE:  
1" = 1320'

Div. Pts. Located: SPRING - 1180 FT. N & 1260 FT. E; STREAM - 930 FT. N & 1240 FT. E,  
BOTH FROM THE W 1/4 COR. SEC. 23

## FINAL PROOF SURVEY UNDER

Application No. 60526. Permit No. 45289.....  
IN NAME OF

BETHEL HEIGHTS VINEYARD

Surveyed APRIL 8, 1988, by T. M. WARREN.

RWK  
PTS W/FF  
41059 17R 219D