


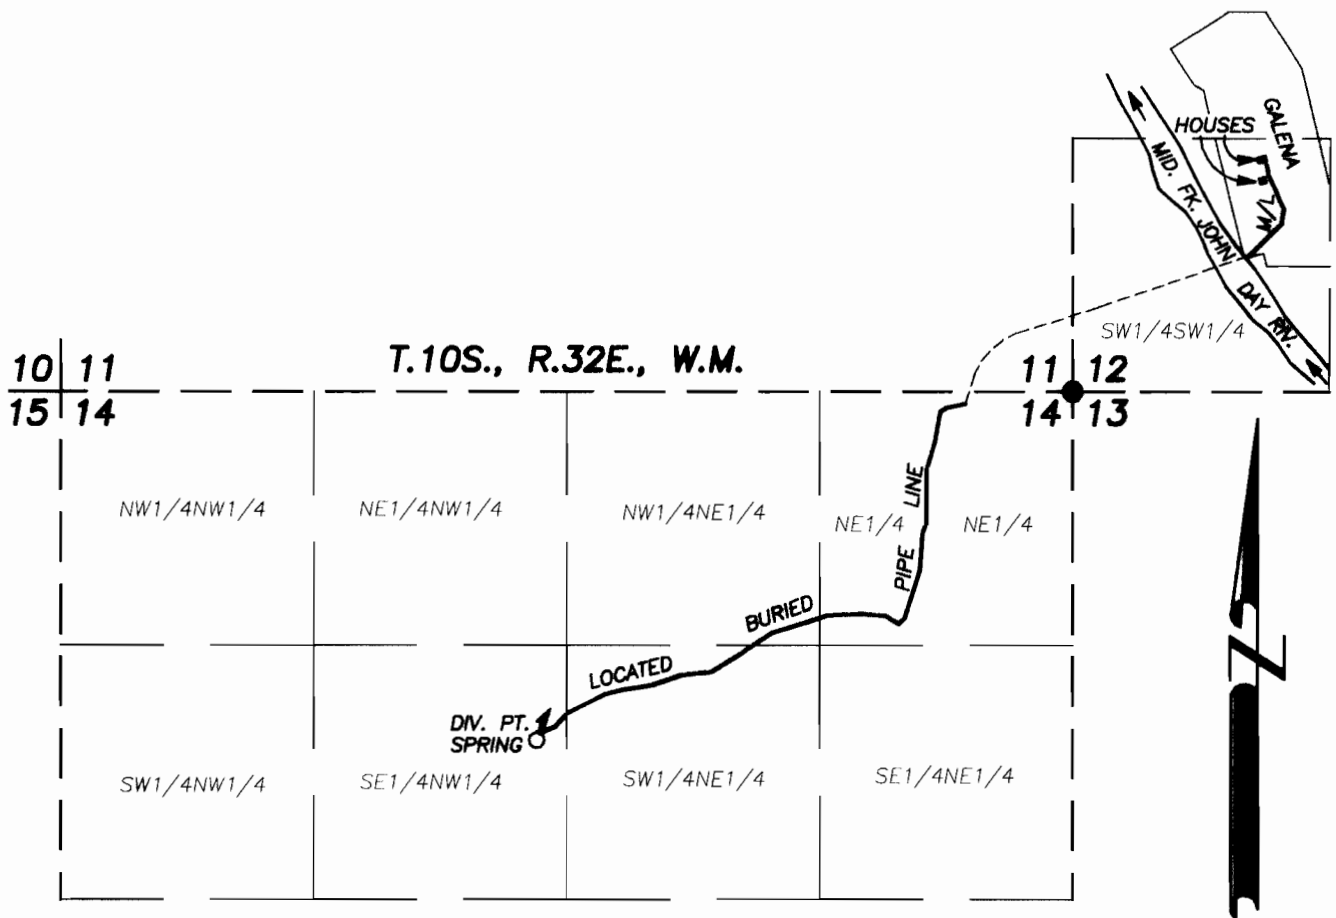


SPRING AND POINT OF APPROPRIATION IS 1810' S. AND 2800' W. OF THE NE COR. SEC. 14, T.10S., R.32E.

SCALE: 1"=1000'

FINAL PROOF SURVEY
 UNDER
PERMIT NO. 53734
APPLICATION NO. S-84512
 IN NAME OF
LARRY L. McMICHAEL

SURVEYED MAY 7, 2002 BY ROBERT D. BAGETT

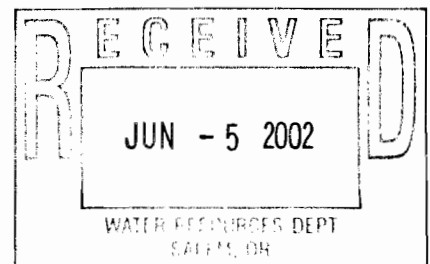

- FOUND 1½" GALV. IRON PIPE WITH ATTACHED GRANT COUNTY SURVEYOR BRASS CAP
- LOCATED BURIED MAINLINE (M/L)
- MAINLINE FROM ESTATE OF GEORGE L. GIBBS FINAL PROOF SURVEY APP. NO. 37160, PERMIT NO. 27678, AUGUST 27, 1971 NOT LOCATED FOR THIS MAP

NOTE: The preparation of this map was for the purpose of identifying the location of the proposed water right and has no intent to provide dimensions or location of property ownership lines.

