


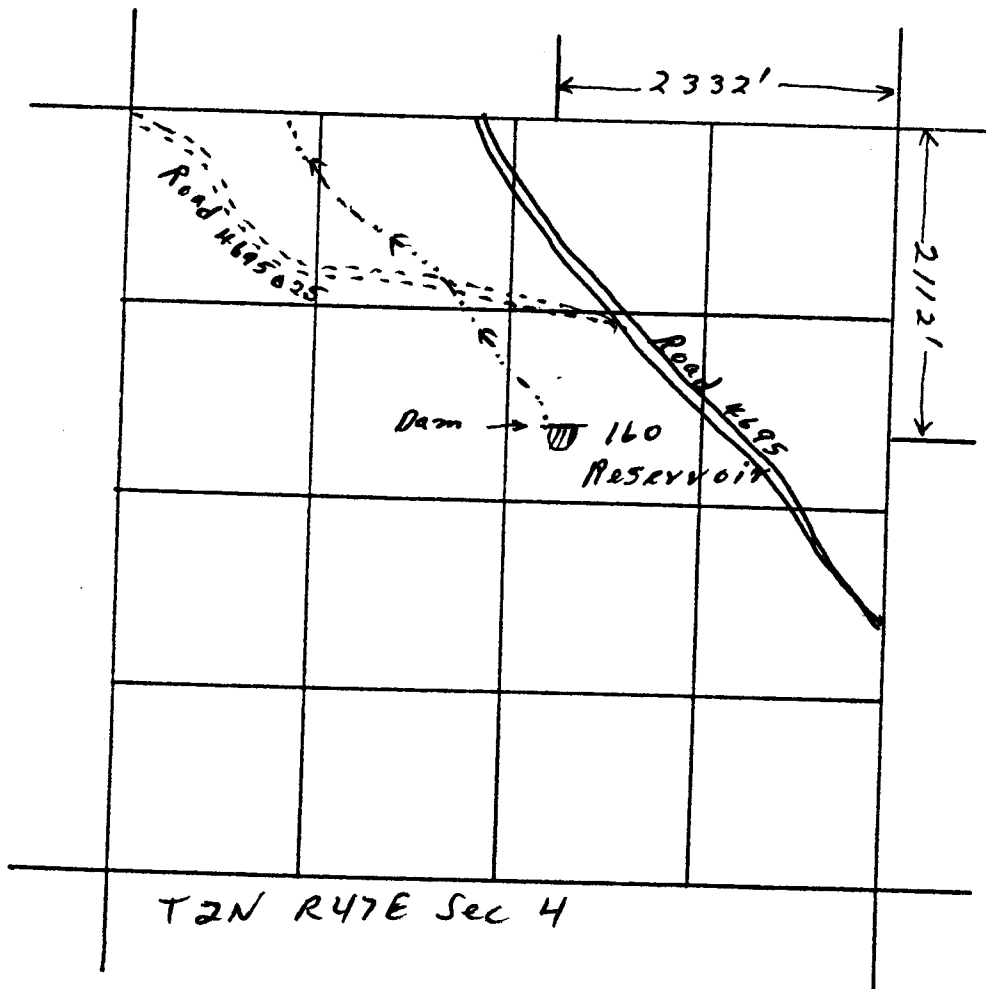

4 inches = 1 mile

Application No. R-65782

Permit No. R10762

RECEIVED

AUG 29 1983

WATER RESOURCES DEPT.
SALEM, OREGON