

UNITED STATES
DEPARTMENT OF THE INTERIOR
BUREAU OF LAND MANAGEMENT


RECEIVED
JUN 25 1960
WATER PROJECT
SHEEP CREEK

SECTION

Oregon State Water Filings

TOWNSHIP 29S, RANGE 15E, W. M.

North TWO SHEEP WATER HOLE

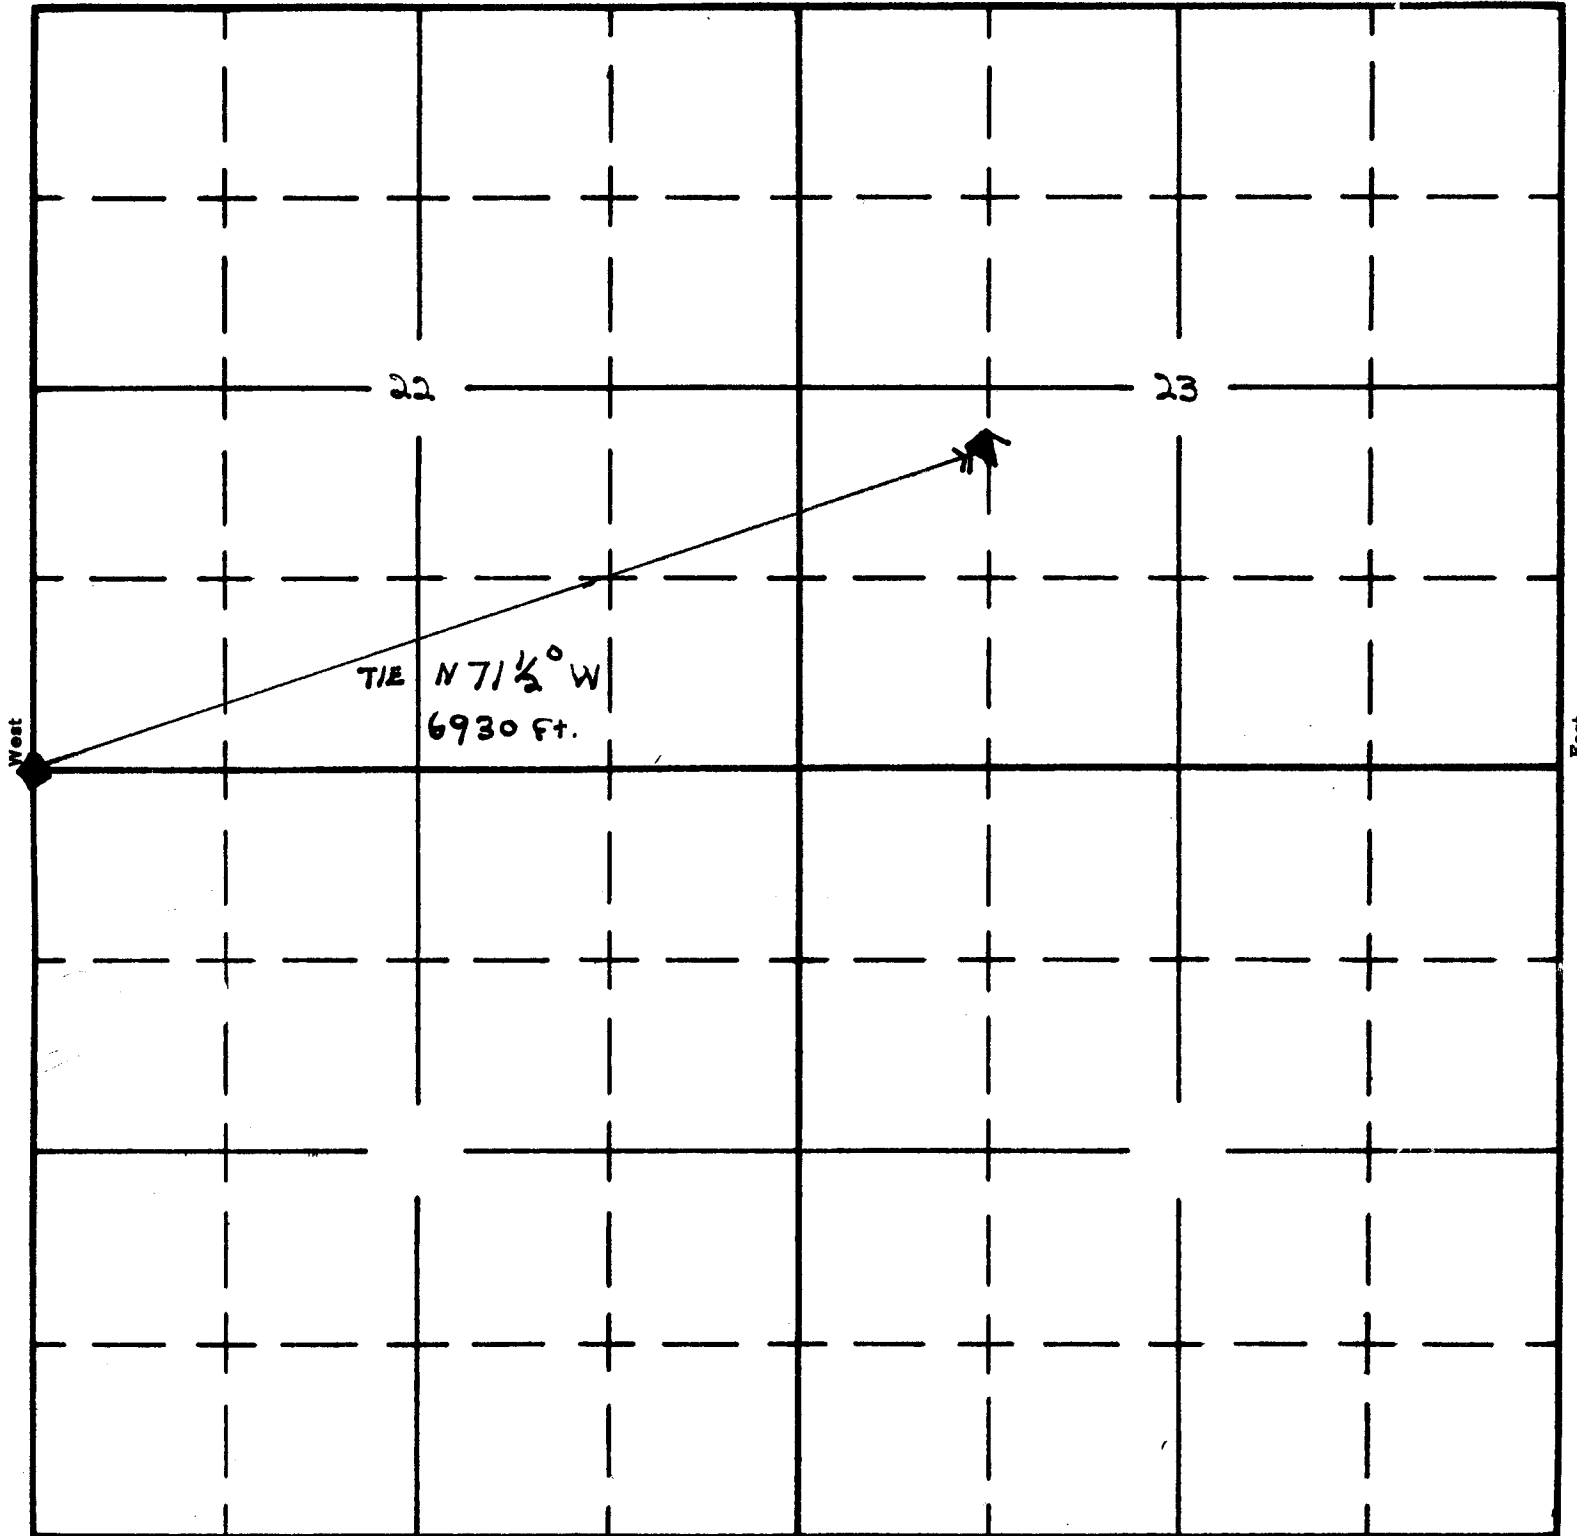

◆ FOUND SURVEY CORNER

South

▼ PROJECT

APPLICATION No. R-34372
PERMIT No. R-2748