


RECEIVED

APR 14 1998

NORTH

WATER RESOURCES DEPT.
SALEM, OREGON

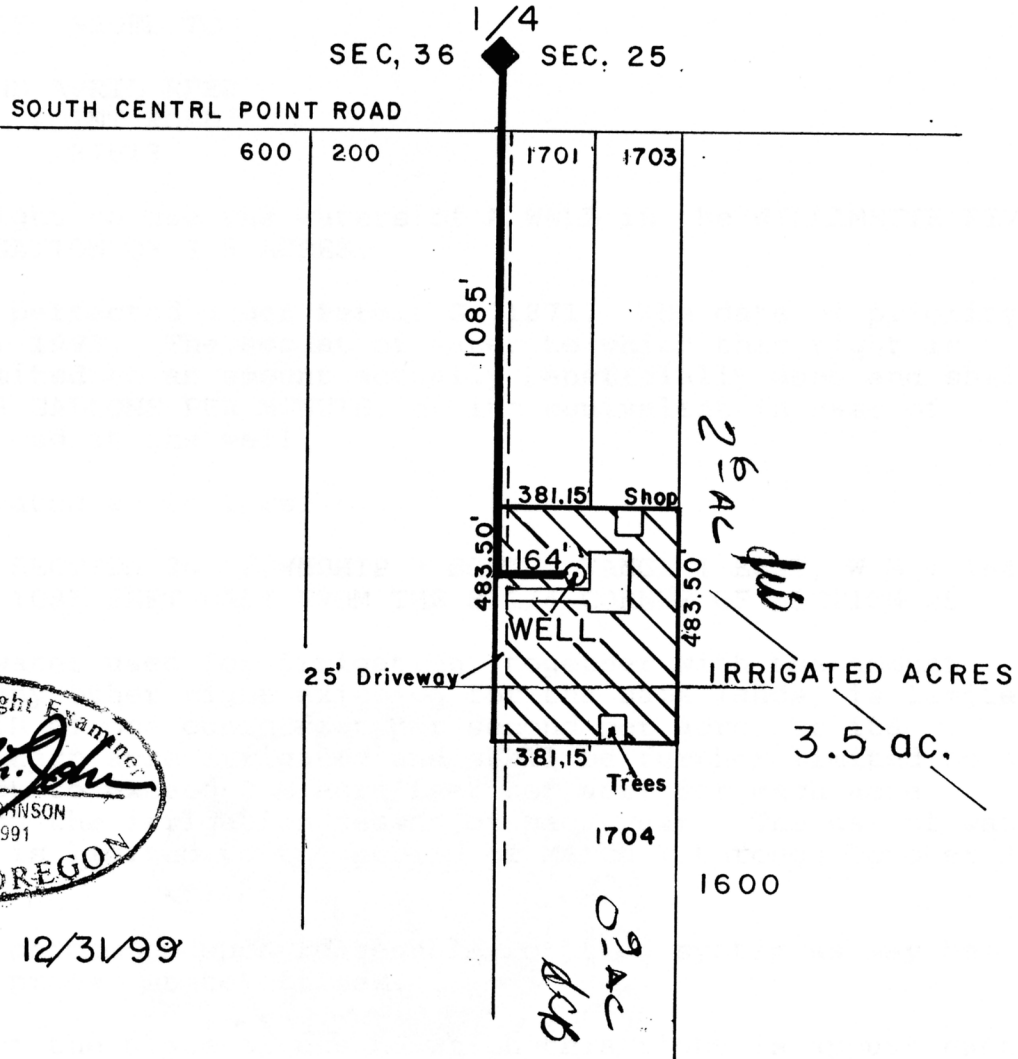

Renewal date 12/31/99

SCALE 1" = 400'

Prepared for:
DEAN SUMPTER and
APRIL REED

FINAL PROOF MAP

Application No: G13584 Permit No: G11871

Located in the S 1/2 of the SE 1/4 of Sec. 25

T. 3 S., R. 1 E., WM
Clackamas Co, OR.

RICHARD JOHNSON, PLS, WRE
19368 Whitney Lane
Oregon City, OR. 97045
(503) 650-0747