


Application No. 70664
Permit No. Certificate 79561

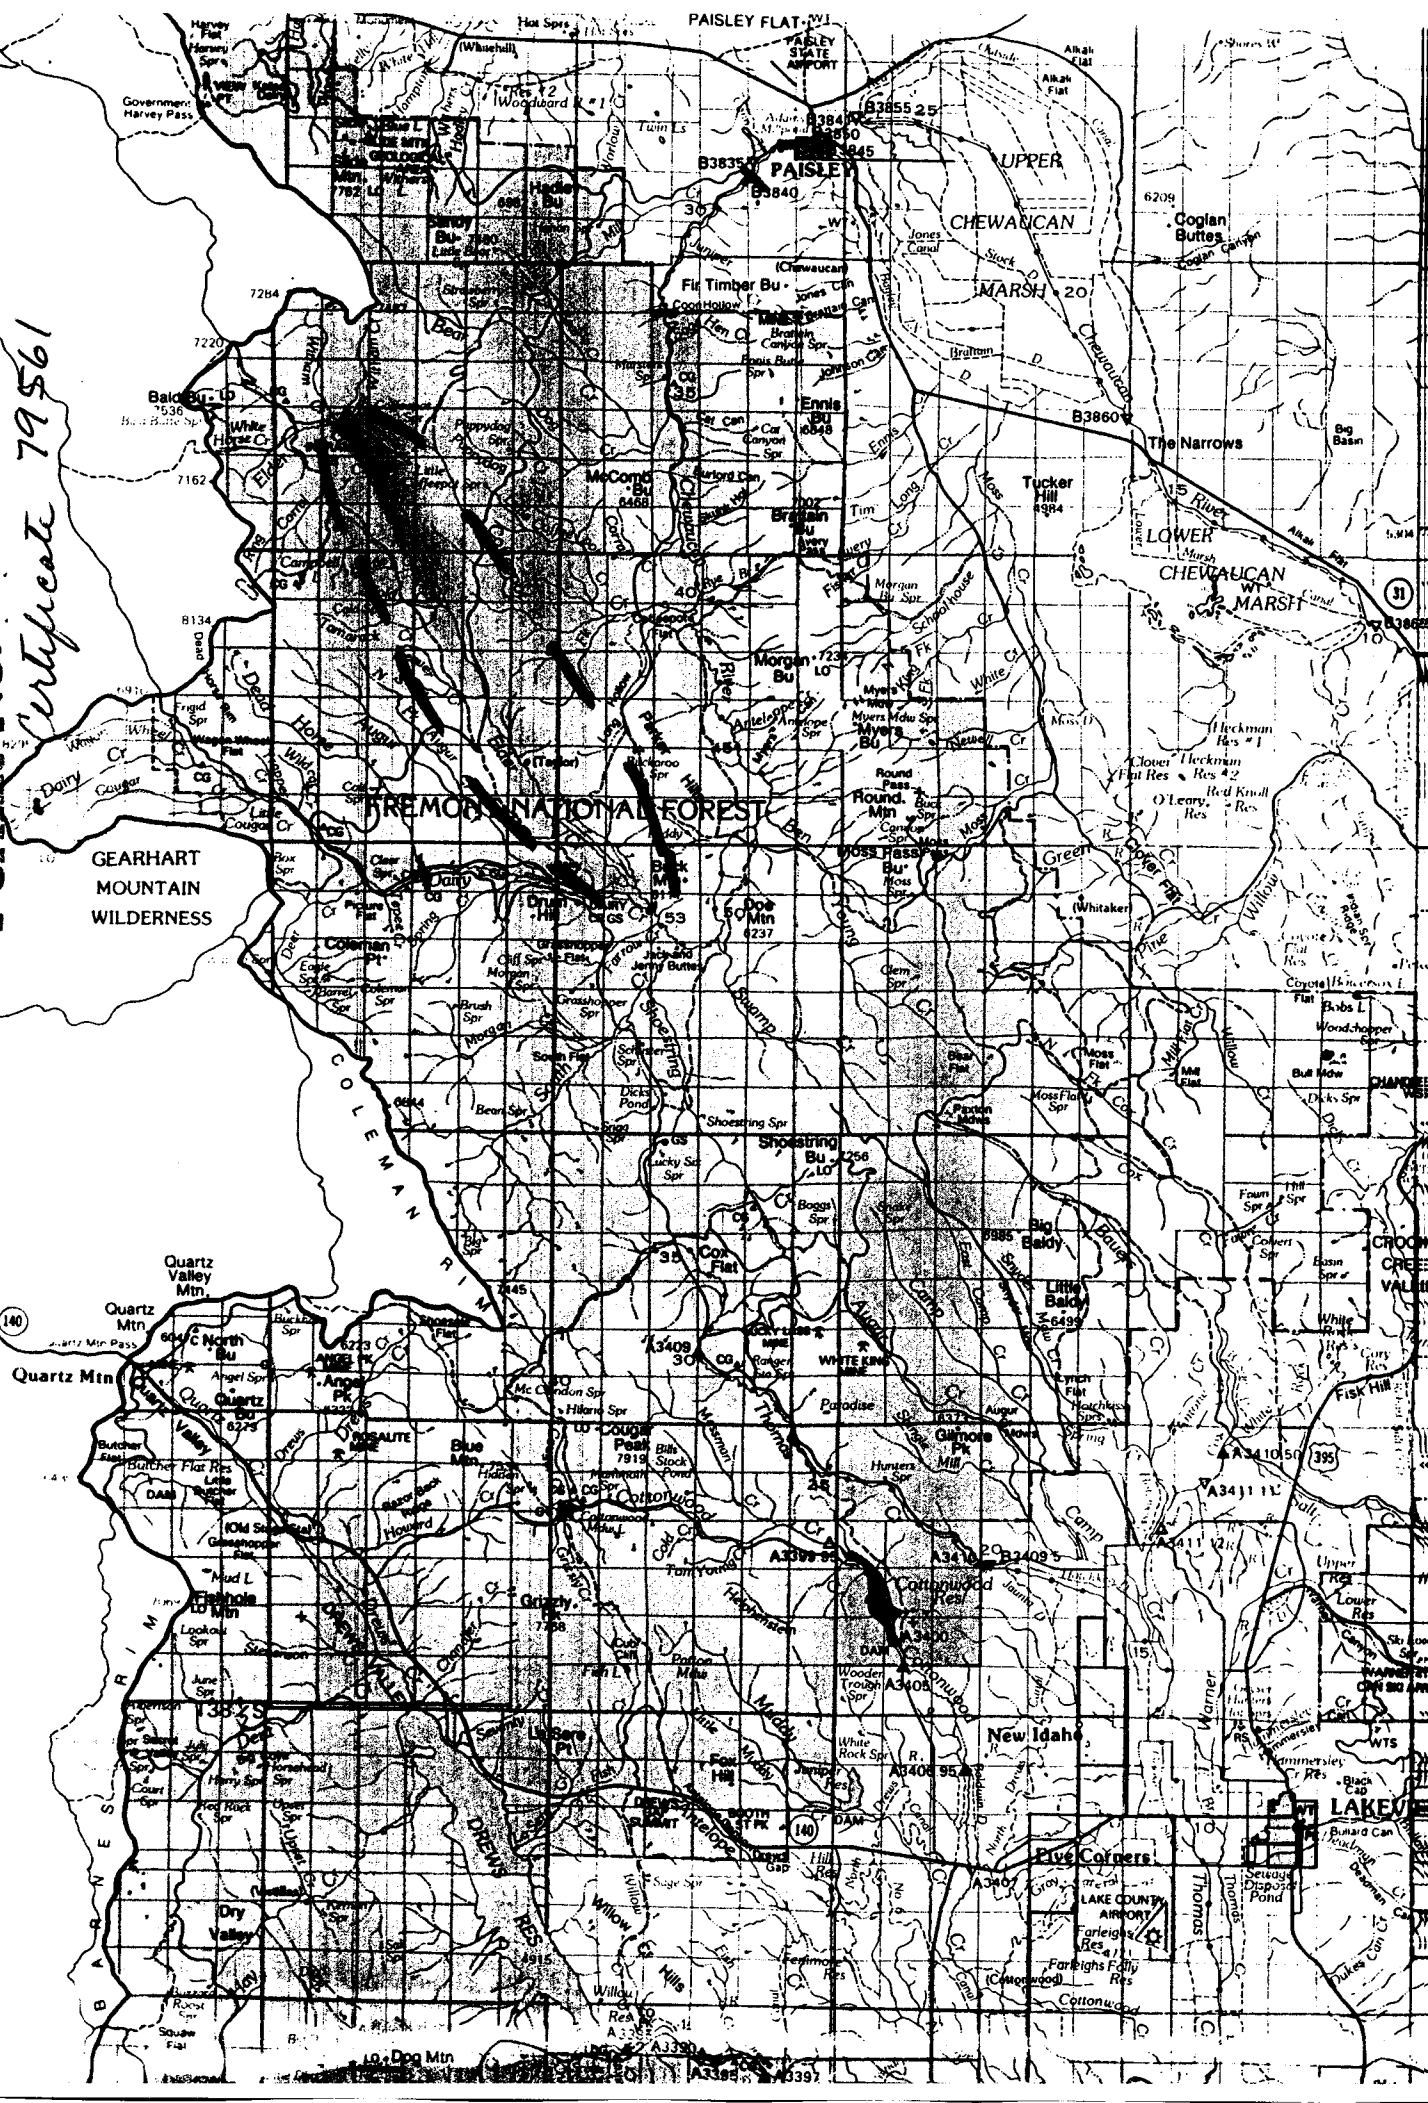

GEARHART
MOUNTAIN
WILDERNESS


PAISLEY STATE AIRPORT

UPPER
CHEWAUCAN
MARSH

LOWER
CHEWAUCAN
MARSH

140

Quartz Mtn

New Idaho

Five Corners

LAKEVIEW