


# T.30S. R.4W. W.M.

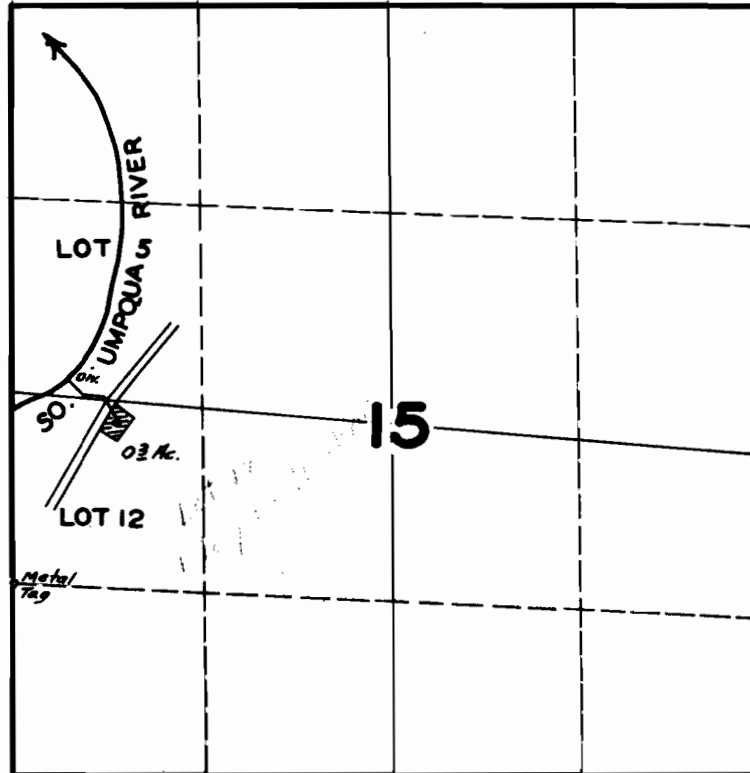

## FINAL PROOF SURVEY UNDER

Application No. 21169 Permit No. 16588

IN NAME OF

CHARLES E. & ALICE E. WHEELER

Surveyed JUNE 3, 1947, by JAS. E. BUNNELL